

MARION  
M 2039  
2-12-80

MISSISSIPPI  
 BOARD OF WATER COMMISSIONERS  
 416 North State Street  
 Jackson, Mississippi 39201

10

WATER WELL DRILLERS LOG  
 TOM GRIFFITH

Feb. 12 19 80  
 date well completed

PLUMBING & WELL SERVICE, INC.  
320 MATSON AVE.  
 COLUMBIA, MS 39429

Marion  
 county well located

LANDOWNER: DAK Connelly  
Rt. 6 BOX 209

description of formations encountered

from to

Columbia  
 (mailing address)

TOP SOIL	0	1
CLAY & CLARK	1	15
SAND & GRAVEL	15	85

WELL LOCATION:

sec. 19 T. 3 (N) R. 12 E

(distance) miles (direction) of (nearest town)

WELL PURPOSE:

(home) irrigation, municipal, industrial

WELL COMPLETION DATA:

- (1) diameter (inches) 2"
- (2) total depth (feet) 85'
- (3) static water level (feet) 15' below top of ground.
- (4) casing 2' plastic (material) (depth)
- (size) if telescope see back.
- (5) screen 20' 65' (length) (depth to top)
- 2" plastic (size) (material)
- (6) pump 1 HP 9 (HP) (yield gpm)
- Electric (type power)
- (7) electric log NO (yes or no)

(organization running log)

(8) how well bottom plugged back-wash VALVE

DEPT. OF NATURAL RESOURCES  
 BUREAU OF LAND & WATER RESOURCES


MAR 10 1980

RECEIVED

DRILLERS REMARKS:

If well telescopes please sketch and show depths.

GROUND LEVEL

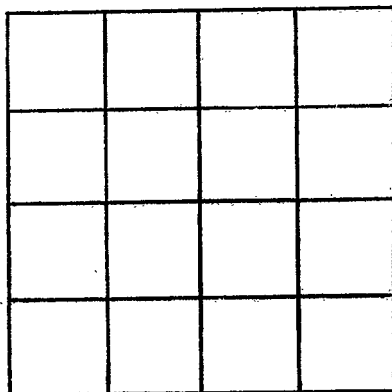

SECTION \_\_\_\_\_

Please indicate well location X.

ADDITIONAL INFORMATION

If more than one screen, show locations of each on sketch.