

MARION  
M 240  
9-8-80

MISSISSIPPI  
BOARD OF WATER COMMISSIONERS  
416 North State Street  
Jackson, Mississippi 39201

WATER WELL DRILLERS LOG

9-8 1980 Hollingsworth Marion  
date well completed firm name county well located

LANDOWNER: Terrell Riley  
Hulk, Ms.  
(mailing address)

description of formations encountered	from	to
CLAY	0	20
CLAY gravel	20	50
pink gas sand	50	67

WELL LOCATION:  
sec. 5 T. 30 N. R. 17 E  
9 miles E of Columbus  
(distance) (direction) (nearest town)

WELL PURPOSE: Home  
(home, irrigation, municipal, industrial)

- WELL COMPLETION DATA:
- (1) diameter (inches) 2"
  - (2) total depth (feet) 67
  - (3) static water level (feet) 30 <sup>below</sup> <sub>above</sub> top of ground.
  - (4) casing PVC  
(material) (depth) \_\_\_\_\_  
(size) \_\_\_\_\_ If telescope see back.
  - (5) screen 5  
(length) (depth to top) \_\_\_\_\_  
PVC 2"  
(size) (material)
  - (6) pump 1 10  
(HP) (yield gpm)  
elect  
(type power)
  - (7) electric log \_\_\_\_\_  
(yes or no)

(organization running log) \_\_\_\_\_

(8) how well bottom plugged sand  
SHANK

DRILLERS REMARKS: Very good well


DEPT. OF NATURAL RESOURCES  
BUREAU OF LAND & WATER RESOURCES

OCT 20 1980

RECEIVED

If well telescopes please sketch and show depths.

GROUND LEVEL

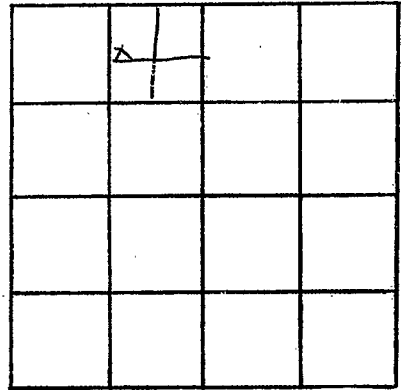

SECTION 5

Please indicate well location X.

ADDITIONAL INFORMATION

If more than one screen, show locations of each on sketch.