

MARION
 M. 241
 6-5-80

MISSISSIPPI
 BOARD OF WATER COMMISSIONERS
 416 North State Street
 Jackson, Mississippi 39201

WATER WELL DRILLERS LOG

6-5 1980 date well completed
 Hollinger firm name
 Marion county well located

LANDOWNER: Joe Cook
 RT6
 Columbia
 (mailing address)

description of formations encountered	from	to
Red clay	0	20
Chalk	20	140
SAND, gravel	140	185

WELL LOCATION:
 sec. 10 T 3(N) S R 17 E
 2 miles E of ENON
 (distance) (direction) (nearest town)

WELL PURPOSE: Home
 (home, irrigation, municipal, industrial)

WELL COMPLETION DATA:
 (1) diameter (inches) 2"
 (2) total depth (feet) 185
 (3) static water level (feet) 100 (below) above top of ground.
 (4) casing PVC 175 (material) (depth)
 (size) If telescope see back.
 (5) screen 10 175 (length) (depth to top)
 2 PVC (size) (material)
 (6) pump 1 1/2 9 (HP) (yield gpm)
 elect (type power)
 (7) electric log (yes or no)
 (organization running log)

(8) how well bottom plugged SAND SHARK

DRILLERS REMARKS:


DEPT. OF NATURAL RESOURCES
 BUREAU OF LAND & WATER RESOURCES

JUL 21 1980

RECEIVED

If well telescopes please sketch and show depths.

GROUND LEVEL

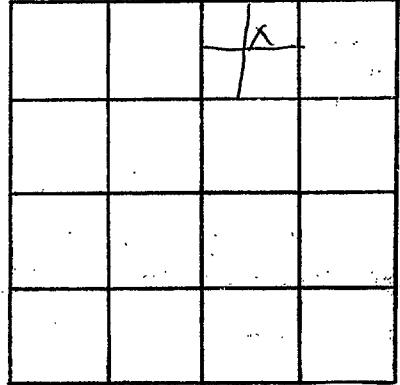

SECTION 10

Please indicate well location X.

ADDITIONAL INFORMATION

If more than one screen, show locations of each on sketch.