

Marion
M 2042
11-15-79

MISSISSIPPI
 BOARD OF WATER COMMISSIONERS
 416 North State Street
 Jackson, Mississippi 39201

WATER WELL DRILLERS LOG

11-15-79 19 Tom Luffich Marion
 date well completed firm name county well located

LANDOWNER:
Mrs. Alva Newson
R.T. 5 Columbia, Ms.
 (mailing address)

description of formations encountered	from	to
<u>Top soil</u>	<u>0</u>	<u>1</u>
<u>Chalk</u>	<u>1</u>	<u>10</u>
<u>Sand</u>	<u>10</u>	<u>65</u>

WELL LOCATION:
 sec. 21 T. 30 S. R. 2 E. W
10 miles S.E. of Columbia
 (distance) (direction) (nearest town)

WELL PURPOSE: Home
 (home, irrigation, municipal, industrial)


- WELL COMPLETION DATA:
- (1) diameter (inches) 2"
 - (2) total depth (feet) 65'
 - (3) static water level (feet) 35' below top of ground.
 - (4) casing Plastic, 55'
 (material) (depth)
2" If telescope see back.
 (size)
 - (5) screen 10', 55'
 (length) (depth to top)
2", Plastic
 (size) (material)
 - (6) pump 1 NO
 (HP) (yield gpm)
Elect.
 (type power)
 - (7) electric log NO
 (yes or no)
NONE
 (organization running log)
 - (8) how well bottom plugged Barv.

DRILLERS REMARKS:

DEPT. OF NATURAL RESOURCES
 BUREAU OF LAND & WATER RESOURCES
 JAN 7 1980
 RECEIVED

If well telescopes please sketch and show depths.

GROUND LEVEL

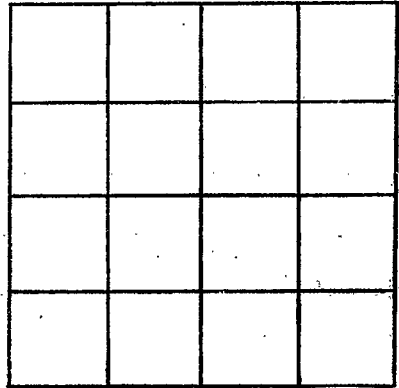

SECTION _____

Please indicate well location X.

ADDITIONAL INFORMATION

If more than one screen, show locations of each on sketch.