

MARION
M243
9-17-79

MISSISSIPPI
 BOARD OF WATER COMMISSIONERS
 416 North State Street
 Jackson, Mississippi 39201

WATER WELL DRILLERS LOG

9-17 1979 Hollinsce's Wells MARION
 date well completed firm name county well located

LANDOWNER: J. Dale Bullock
RT 6 Box 247
Columbic, MS
 (mailing address)

description of formations encountered	from	to
<u>sand</u>	<u>0</u>	<u>30</u>
<u>clay</u>	<u>30</u>	<u>90</u>
<u>sand, gravel</u>	<u>90</u>	<u>107</u>

WELL LOCATION:
 sec. 5 T. 3 (N) R. 17 (E)
11 miles E of Columbic
 (distance) (direction) (nearest town)

WELL PURPOSE: Home
 (home, irrigation, municipal, industrial)

- WELL COMPLETION DATA:
- (1) diameter (inches) 2
 - (2) total depth (feet) 107
 - (3) static water level (feet) 60 below above top of ground.
 - (4) casing pvc 97
 (material) (depth)
 (size) if telescope see back.
 - (5) screen 10 97
 (length) (depth to top)
2 pvc
 (size) (material)
 - (6) pump 1 8
 (HP) (yield gpm)
elect
 (type power)
 - (7) electric log
 (yes or no)

(organization running log)

(8) how well bottom plugged sand
SHARK

DRILLERS REMARKS: Good well


DEPT. OF NATURAL RESOURCES
 BUREAU OF LAND & WATER RESOURCES

NOV 15 1979

RECEIVED

If well telescopes please sketch and show depths.

GROUND LEVEL

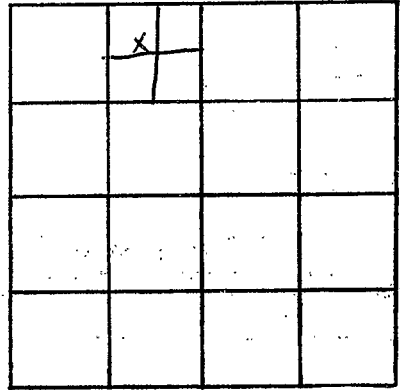

SECTION 3

Please indicate well location X.

ADDITIONAL INFORMATION

A series of horizontal lines for writing additional information.

If more than one screen, show locations of each on sketch.