

Mason  
M  
204  
8-3-79  
August 3 1979  
 date well completed

MISSISSIPPI  
 BOARD OF WATER COMMISSIONERS  
 416 North State Street  
 Jackson, Mississippi 39201

WATER WELL DRILLERS LOG

TOM GRIFFITH  
 PLUMBING & WELL SERVICE, INC.  
 firm name

Mason  
 county well located

LANDOWNER:  
Dr. Ronald French  
1795 Cellum St  
New Orleans (mailing address) La-

description of formations encountered	from	to
<u>Top Soil</u>	<u>0</u>	<u>1</u>
<u>Clay</u>	<u>1</u>	<u>70</u>
<u>Sand</u>	<u>70</u>	<u>39</u>
<u>Gravel</u>	<u>39</u>	<u>72</u>
<u>Chalk</u>	<u>72</u>	<u>140</u>
<u>Sand</u>	<u>140</u>	<u>210</u>
<u>Gravel</u>	<u>210</u>	<u>231</u>
<u>Sand</u>	<u>231</u>	<u>270</u>

WELL LOCATION:  
 sec. 4 T. 3 N. R. 17 E.  
S 5 miles S of Edouville  
 (distance) (direction) (nearest town)

WELL PURPOSE: Home  
 (home, irrigation, municipal, industrial)

- WELL COMPLETION DATA:
- (1) diameter (inches) 4"
  - (2) total depth (feet) 270 ft.
  - (3) static water level (feet) 165 ft. below top of ground.
  - (4) casing plastic 250 ft.  
 (material) (depth)  
4"  
 (size) if telescope see back.
  - (5) screen 20 ft. 250 ft.  
 (length) (depth to top)  
4" plastic  
 (size) (material)
  - (6) pump 1 HP 12  
 (HP) (yield gpm)  
Electric  
 (type power)
  - (7) electric log No.  
 (yes or no)
- (organization running log)

DEPT. OF NATURAL RESOURCES  
 BUREAU OF LAND & WATER RESOURCES


NOV 21 1979

RECEIVED

(8) how well bottom plugged  
Back Wash Valve  
 DRILLERS REMARKS:

If well telescopes please sketch and show depths.

GROUND LEVEL

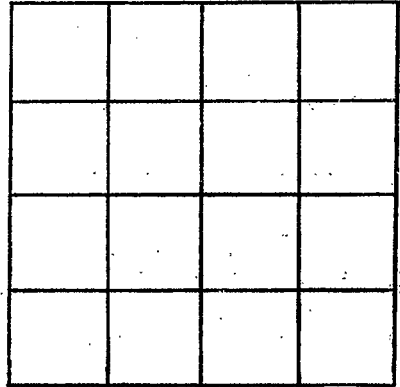

SECTION \_\_\_\_\_

Please indicate well location X.

ADDITIONAL INFORMATION

If more than one screen, show locations of each on sketch.