

Marion  
 M 245  
 6/21/79

MISSISSIPPI  
 BOARD OF WATER COMMISSIONERS  
 416 North State Street  
 Jackson, Mississippi 39201

WATER WELL DRILLERS LOG

6/21 1979 Hollinger MARION  
 date well completed firm name county well located

LANDOWNER: <u>William Peake</u> <u>RT 2</u>	description of formations encountered	from	to
<u>Columbia, Ms.</u> (mailing address)	<u>sand gravel</u> <u>CHALK</u> <u>SAND</u>	<u>0</u> <u>50</u> <u>180</u>	<u>50</u> <u>180</u> <u>227</u>
WELL LOCATION: sec. <u>10</u> T. <u>30</u> (N) R. <u>13</u> (W) <u>17</u> <u>2</u> miles <u>N</u> of <u>Pineburg</u> (distance) (direction) (nearest town)			
WELL PURPOSE: <u>Home</u> (home, irrigation, municipal, industrial)			
WELL COMPLETION DATA:			
(1) diameter (inches) <u>2"</u>			
(2) total depth (feet) <u>227</u>			
(3) static water level (feet) <u>100</u> <u>below</u> above top of ground.			
(4) casing <u>pvc</u> <u>217</u> (material) (depth)			
(size) if telescope see back.			
(5) screen <u>10</u> <u>217</u> (length) (depth to top)			
(6) pump <u>2</u> <u>pvc</u> (size) (material)			
(6) pump <u>elect</u> <u>7</u> (HP) (yield gpm)			
(type power) <u>elect.</u>			
(7) electric log <u>                    </u> (yes or no)			
(organization running log) <u>                    </u>			
(8) how well bottom plugged <u>sand</u> <u>SHARIC</u>			
DRILLERS REMARKS: <u>Very Good</u>			


Miss. Board of Water Comm.

JUL 20 1979

RECEIVED

If well telescopes please sketch and show depths.

GROUND LEVEL

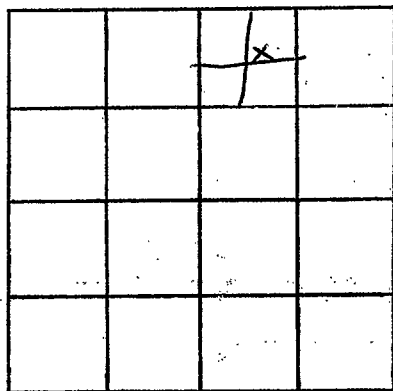

SECTION 10

Please indicate well location X.

ADDITIONAL INFORMATION

If more than one screen,  
show locations of each on sketch.