

MARION
M 2046
7/7/79

MISSISSIPPI
BOARD OF WATER COMMISSIONERS
416 North State Street
Jackson, Mississippi 39201

WATER WELL DRILLERS LOG

7/7 1979 Hollinger MARION
date well completed: firm name county well located

LANDOWNER: Wilmer Byrd
RT 2
Columbia, Ms.
(mailing address)

| description of formations encountered | from | to |
|---------------------------------------|------|-----|
| Sand, gravel | 0 | 60 |
| CHALK | 60 | 180 |
| Sand, fine gravel | 180 | 200 |

WELL LOCATION:
sec. 11 T. 30 N R. 12 E
3 miles N of Ancker
(distance) (direction) (nearest town)

WELL PURPOSE: Home
(home, irrigation, municipal, industrial)

- WELL COMPLETION DATA:
- (1) diameter (inches) 2
 - (2) total depth (feet) 200
 - (3) static water level (feet) 70 below above top of ground.
 - (4) casing PVC 190 (material) (depth)
 - (size) If telescope see back.
 - (5) screen 10 190 (length) (depth to top)
 - 2 PVC (size) (material)
 - (6) pump 1 8 (HP) (yield gpm)
 - elect (type power)
 - (7) electric log (yes or no)

(organization running log)

(8) how well bottom plugged Sand SHARK

DRILLERS REMARKS: Very Good


Miss. Board of Water Comm.

JUL 25 1979

RECEIVED

If well telescopes please sketch and show depths.

GROUND LEVEL

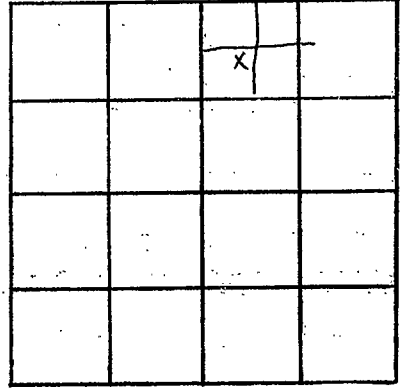

SECTION _____

Please indicate well location X.

ADDITIONAL INFORMATION

Multiple horizontal lines for additional information.

If more than one screen, show locations of each on sketch.