

Marion
M
2047

MISSISSIPPI DEPARTMENT OF NATURAL RESOURCES

Bureau of Land and Water Resources

Southport Mall

P.O. Box 10631

Jackson, Mississippi 39209

WATER WELL DRILLERS LOG

TOM GRIFFITH

PLUMBING & WELL SERVICE, INC.

Marion

3-13 1984
date well completed

620 W. MAYSON AVE.
COLUMBIA, MISSISSIPPI 39201

county well located

LANDOWNER: Ollie Pearl Bullock

description of formations encountered

from

to

1766 Park 31/2

Sand

1' 30'

Columbia, Ms 39479
(mailing address)

Clay

30' 210'

Sand

210' 240'

WELL LOCATION:

sec. 10 T 30^N R 17 E
10 miles E of Columbia
(distance) (direction) (nearest town)

WELL PURPOSE: Home
(home, irrigation, municipal, industrial)

WELL COMPLETION DATA:

- (1) diameter (inches) 2"
- (2) total depth (feet) 240'
- (3) static water level (feet) 150' below top of ground.
- (4) casing PVC, 220' (material), (depth)
N/A if telescope see back.
- (5) screen 20' (length), 220' (depth to top)
2" (size), PVC (material)
- (6) pump 2 (HP), 6 (yield gpm)
EPEC (type power), 3 1/2 hp jet
- (7) electric log N/A (yes or no)
N/A (organization running log)
- (8) how well bottom plugged BWV

DRILLERS REMARKS:


DEPT. OF NATURAL RESOURCES
BUREAU OF LAND & WATER RESOURCES

MAY - 2 1984

RECEIVED

If well telescopes please sketch and show depths.

GROUND LEVEL

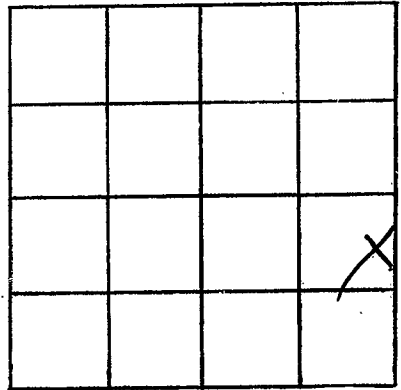

SECTION 10

Please indicate well location X.

ADDITIONAL INFORMATION

If more than one screen, show locations of each on sketch.