

MISSISSIPPI DEPARTMENT OF NATURAL RESOURCES

Bureau of Land and Water Resources

Southport Mall

P.O. Box 10631

Jackson, Mississippi 39209

WATER WELL DRILLERS LOG

TOM GRIFFITH

PLUMBING & WELL SERVICE, INC.

520 MAYSON AVE.

COLUMBIA, MS 39429

Marion
M
2048

7/29/83 19
date well completed

Marion
county well located

LANDOWNER: Don Smith

Rt. 5 Box 321

Columbia, MS 39429
(mailing address)

description of formations encountered

Clay - Gravel
Sand
Chalk

from to
0' 40'
40' 55'
55' 70'

WELL LOCATION:

sec 36 T 30 N R 17 E
S W
10 miles NE of Columbia
(distance) (direction) (nearest town)

WELL PURPOSE: Home
(home, irrigation, municipal, industrial)

WELL COMPLETION DATA:

- (1) diameter (inches) 4"
- (2) total depth (feet) 50'
- (3) static water level (feet) 30' below top of ground.
- (4) casing PVC, 40' (material) (depth)
N/A if telescope see back.
(size)
- (5) screen 10' 40' (length) (depth to top)
4" PVC (size) (material)
- (6) pump 1/2 10 (HP) (yield gpm)
Elec. (type power)
- (7) electric log N/A (yes of no)
N/A (organization running log)
- (8) how well bottom plugged BUUV

DRILLERS REMARKS:


DEPT. OF NATURAL RESOURCES
BUREAU OF LAND & WATER RESOURCES

FEB 16 1984

RECEIVED

If well telescopes please
sketch and show depths.

GROUND LEVEL

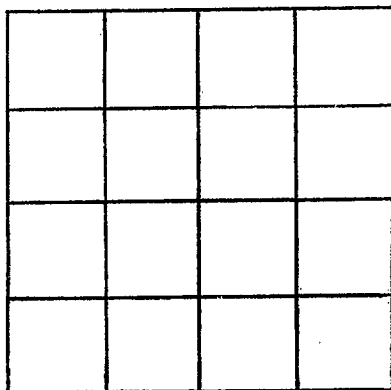

SECTION _____

Please indicate well location X.

ADDITIONAL INFORMATION

If more than one screen,
show locations of each on sketch.