

Marion
M
2049

MISSISSIPPI DEPARTMENT OF NATURAL RESOURCES
Bureau of Land and Water Resources
Southport Mall
P.O. Box 10631
Jackson, Mississippi 39209

WATER WELL DRILLERS LOG

TOM GRIFFITH

PLUMBING & WELL SERVICE, INC. Marion

7/29/83
date well completed 19

320 WAYSON AVE.
COLUMBIA, MS 39429

county well located

LANDOWNER: Don Smith

Rt. 5 Box 321

Columbia, MS 39429
(mailing address)

WELL LOCATION:

sec. 36 T 30 N R 17 E
10 miles E of Columbia
(distance) (direction) (nearest town)

WELL PURPOSE: Home
(home, irrigation, municipal, industrial)

WELL COMPLETION DATA:

- (1) diameter (inches) 4"
- (2) total depth (feet) 95'
- (3) static water level (feet) 40' below top of ground.
- (4) casing PVC 85'
(material) (depth)
- N/A if telescope see back.
(size)
- (5) screen 10' 85'
(length) (depth to top)
- 4" PVC
(size) (material)
- (6) pump 1/2 10
(HP) (yield gpm)
- Elec.
(type power)
- (7) electric log N/A
(yes or no)
- N/A
(organization running log)
- (8) how well bottom plugged BUV

description of formations encountered	from to	
Sand	0'	5'
Chalk	5'	20'
Sand & Pea Gravel	20'	95'

DRILLERS REMARKS:


DEPT. OF NATURAL RESOURCES
BUREAU OF LAND & WATER RESOURCES

FEB 16 1984

RECEIVED

If well telescopes please sketch and show depths.

GROUND LEVEL

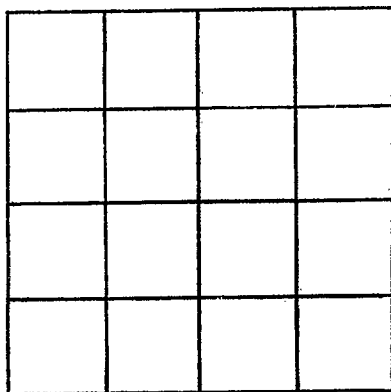

SECTION _____

Please indicate well location X.

ADDITIONAL INFORMATION

If more than one screen,
show locations of each on sketch.