

MARION
M 2050

MISSISSIPPI
BOARD OF WATER COMMISSIONERS
416 North State Street
Jackson, Mississippi 39201

WATER WELL DRILLERS LOG

10/15 1985 Tom Griffithy
date well completed 85 celder well firm name Marion county well located


LANDOWNER: Robert Simmons Key Ave.	description of formations encountered	from	to
Columbia, MS 39429 (mailing address)	Red Sand Clay gravel Gravel	1 20 60	20 60 160
WELL LOCATION:			
sec. 3 T. 3 (N) R. 12 E Eastern Part S of Columbia miles (distance) (direction) (nearest town)			
WELL PURPOSE: home irrigation (home, irrigation, municipal, industrial)			
WELL COMPLETION DATA:			
(1) diameter (inches) 4"			
(2) total depth (feet) 160'			
(3) static water level (feet) 25' ^{below} above top of ground.			
(4) casing PVC, 140' (material) (depth) NA #2 (size) if telescope see back.			
(5) screen 20' 140' (length) (depth to top) 4" PVC (size) (material)			
(6) pump 1/4 HP 35 (HP) (yield gpm)			
desisel (type power)			
(7) electric log NO (yes or no) NA (organization running log)			
(8) how well bottom plugged BWV			
DRILLERS REMARKS:			

THE MISSISSIPPI
TAX
FFB - 7 1986

Department of Natural Resources
Bureau of Land & Water Resources

If well telescopes please sketch and show depths.

GROUND LEVEL

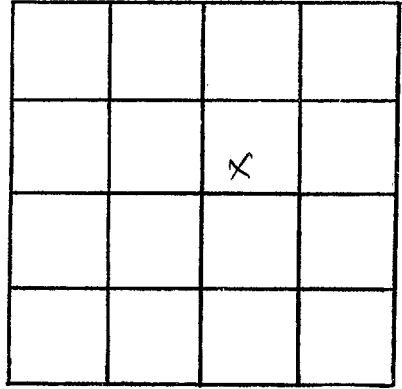

SECTION _____

Please indicate well location X.

ADDITIONAL INFORMATION

If more than one screen,
show locations of each on sketch.