

MISSISSIPPI DEPARTMENT OF NATURAL RESOURCES

Bureau of Land and Water Resources

Southport Mall

P.O. Box 10631

Jackson, Mississippi 39209

WATER WELL DRILLERS LOG

MARION
M 2057
4/1/86

date well completed 19

Tom Griffith Well Service

firm name

Marion

county well located

LANDOWNER: JOE PEAVY

description of formations encountered

from

to

CLAY / Gravel

1

80

SAND

80

90

(mailing address)

CLAY

90

180

WELL LOCATION:

SAND + P-Gravel

180

300

sec. 20 T 3 N S R 17 E W

miles of Columbia (distance) (direction) (nearest town)

WELL PURPOSE: HOME (home, irrigation, municipal, industrial)

WELL COMPLETION DATA:

- (1) diameter (inches) 4"
- (2) total depth (feet) 300'
- (3) static water level (feet) 180' below top of ground.

(4) casing PVC, 280' (material), (depth), 4" (size) if telescope see back.

(5) screen 20', 280' (length), (depth to top), 4" (size), PVC (material)

(6) pump (HP) 40 (yield gpm), (type power)

(7) electric log No (yes or no)

(organization running log) N/A

(8) how well bottom plugged RDU

DRILLERS REMARKS:


RECEIVED

NOV 7 1986

Department of Natural Resources Bureau of Land & Water Resources

If well telescopes please sketch and show depths.

GROUND LEVEL

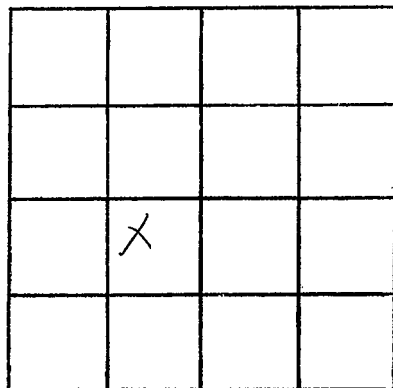

SECTION \_\_\_\_\_

Please indicate well location X.

ADDITIONAL INFORMATION

If more than one screen,  
show locations of each on sketch.