

Marion  
M 2052

MISSISSIPPI DEPARTMENT OF NATURAL RESOURCES  
Bureau of Land and Water Resources  
Southport Mall  
P.O. Box 10631  
Jackson, Mississippi 39209  
WATER WELL DRILLERS LOG

5-15-86 19 Tom Griffith Well Service Marion  
date well completed firm name county well located

LANDOWNER: <u>Betty Grant</u> <u>RFI</u>	description of formations encountered	from	to
<u>Columbia, MS</u> (mailing address)	<u>CLAY SAND</u>	<u>0</u> <u>40</u>	<u>40</u> <u>120</u>
WELL LOCATION:			
sec. <u>26</u> T- <u>3</u> R- <u>17</u> <u>8</u> miles <u>SE</u> of <u>Columbia</u> (distance) (direction) (nearest town)			
WELL PURPOSE: <u>Home</u> (home, irrigation, municipal, industrial)			
WELL COMPLETION DATA:			
(1) diameter (inches) <u>4"</u>			
(2) total depth (feet) <u>120</u>			
(3) static water level (feet) <u>80</u> below above top of ground.			
(4) casing <u>PVC</u> , <u>100'</u> (material) (depth) <u>4"</u> if telescope see back. (size)			
(5) screen <u>20'</u> , <u>100'</u> (length) (depth to top) <u>4"</u> , <u>PVC</u> (size) (material)			
(6) pump <u>—</u> , <u>40</u> (HP) (yield gpm) <u>—</u> (type power)			
(7) electric log <u>N/A</u> (yes or no) <u>N/A</u> (organization running log)			
(8) how well bottom plugged <u>BWV</u>			
DRILLERS REMARKS:			


RECEIVED

SEP 28 1987

Dept. of Natural Resources  
Bureau of Land & Water Resources

If well telescopes please sketch and show depths.

GROUND LEVEL

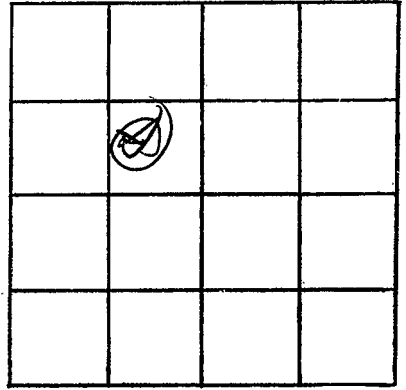

SECTION 26

Please indicate well location X.

ADDITIONAL INFORMATION

Multiple horizontal lines for additional information.

If more than one screen, show locations of each on sketch.