

Marion
M 2054

MISSISSIPPI DEPARTMENT OF NATURAL RESOURCES
Bureau of Land and Water Resources
Southport Mall
P.O. Box 10631
Jackson, Mississippi 39209
WATER WELL DRILLERS LOG

copy

11-29 1986 Hollensen Marion
date well completed firm name county well located

LANDOWNER: Sandi Wisecup
RT 2 Box 310
Columbia MS
(mailing address)

description of formations encountered	from	to
	<u>SAND</u>	<u>0</u>
<u>CLAY</u>	<u>30</u>	<u>180</u>
<u>Sandy gravel</u>	<u>180</u>	<u>26</u>

WELL LOCATION:
sec. 16 T. 30 N. R. 17 E
6 1/2 miles E of Columbia
(distance) (direction) (nearest town)

WELL PURPOSE:
(home, irrigation, municipal, industrial)

WELL COMPLETION DATA:

- (1) diameter (inches) 4"
- (2) total depth (feet) 260
- (3) static water level (feet) 120 below above
top of ground.
- (4) casing pvc 260
(material) (depth)
 if telescope see back.
(size)
- (5) screen 10 250
(length) (depth to top)
4 pvc
(size) (material)
- (6) pump 1 1/2 20
(HP) (yield gpm)
elect
(type power)
- (7) electric log
(yes or no)

(organization running log)

(8) how well bottom plugged sand
stone

DRILLERS REMARKS: Very Good
well


RECEIVED

DEC 11 1986

Department of Natural Resources
Bureau of Land & Water Resources

If well telescopes please sketch and show depths.

GROUND LEVEL

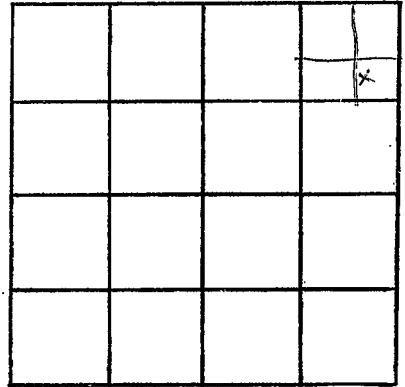

SECTION 16

Please indicate well location X.

ADDITIONAL INFORMATION

If more than one screen,
show locations of each on sketch.