

MISSISSIPPI DEPARTMENT OF NATURAL RESOURCES

Bureau of Land and Water Resources

Southport Mall

P.O. Box 10631

Jackson, Mississippi 39209

WATER WELL DRILLERS LOG

Marion
M 2056

12-14 1987
date well completed

Hollinger
firm name

Marion
county well located

LANDOWNER:
Dorothy Bebee
RT 5
Columbia (mailing address)

description of formations encountered	from	to
<u>Chalk</u>	<u>0</u>	<u>80</u>
<u>Coarse sand, gravel</u>	<u>80</u>	<u>105</u>

WELL LOCATION:
sec. 14 T. 30 N. R. 17 E.
10 miles E of Columbia
(distance) (direction) (nearest town)

WELL PURPOSE:
(home, irrigation, municipal, industrial)

WELL COMPLETION DATA:

(1) diameter (inches) 2"

(2) total depth (feet) 105

(3) static water level (feet) 18 below top of ground.

(4) casing 2" (material) PVC (depth)

2" if telescope see back. (size)

(5) screen 10 (length) 95 (depth to top)

2 (size) (material)

(6) pump 1 (HP) 15 (yield gpm)

elect (type power)

(7) electric log yes or no

(organization running log)

(8) how well bottom plugged sand
SHARK

RECEIVED


DEC 15 1987

Department of Natural Resources
Bureau of Land & Water Resources

DRILLERS REMARKS: Decent

If well telescopes please sketch and show depths.

GROUND LEVEL

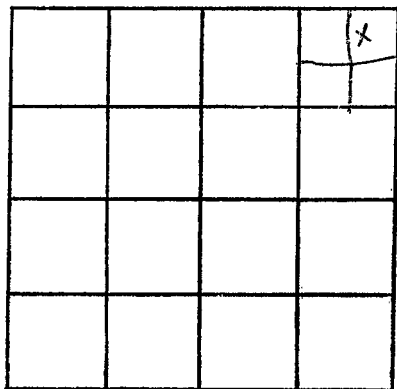

SECTION 14

Please indicate well location X.

ADDITIONAL INFORMATION

If more than one screen, show locations of each on sketch.