

Marion  
M 2559

MISSISSIPPI DEPARTMENT OF NATURAL RESOURCES  
Bureau of Land and Water Resources  
Southport Mall  
P.O. Box 10631  
Jackson, Mississippi 39209  
WATER WELL DRILLERS LOG

11-20 1989 date well completed  
Louis Batson firm name  
Marion county well located

LANDOWNER: Joan Thornhill

description of formations encountered

from to

Rt. 1

Sand, gravel 1 105

Columbia, MS. 39429  
(mailing address)

WELL LOCATION:

sec. 12 T 3 N S R 17 E W  
2 miles N of Columbia  
(distance) (direction) (nearest town)

WELL PURPOSE: home  
(home, irrigation, municipal, industrial)

WELL COMPLETION DATA:

- (1) diameter (inches) 2"  
(2) total depth (feet) 105  
(3) static water level (feet) 45 below above top of ground.  
(4) casing 2' PVC 105' (material) (depth)  
2" (size) if telescope see back.  
(5) screen 10 95 (length) (depth to top)  
2" PVC 40 (size) (material)  
(6) pump 1 (HP) (yield gpm)  
220 (type power)  
(7) electric log (yes or no)  
(organization running log)  
(8) how well bottom plugged

DRILLERS REMARKS:

MISSISSIPPI DEPARTMENT OF NATURAL RESOURCES  
Bureau of Land and Water Resources  
Director of Land and Water Resources

RCES


well telescopes please  
sketch and show depths.

GROUND LEVEL

- 105 ft

- 10 ft  
Screen

If more than one screen,  
show locations of each on sketch.

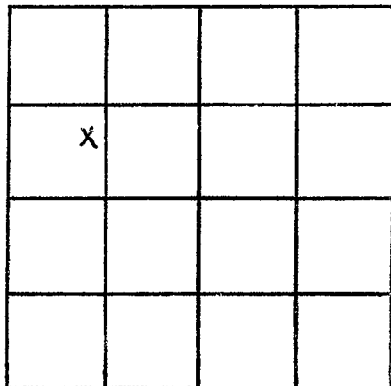

SECTION 12

Please indicate well location X.

ADDITIONAL INFORMATION

Series of horizontal lines for additional information.