

MISSISSIPPI DEPARTMENT OF NATURAL RESOURCES
Bureau of Land and Water Resources
 Southport Mall
 P.O. Box 10631
 Jackson, Mississippi 39209
WATER WELL DRILLERS LOG

Marion
M 2060

3-26 1990 Louis Batson Marion
 date well completed firm name county well located

LANDOWNER: Bennie Cook
Rt. 2, Box 191
Columbia, MS. 39429
 (mailing address)

description of formations encountered	from	to
Sand	1	15
Chalk	15	85
Sand, gravel	85	100

WELL LOCATION:
 sec. 20 T. 3 S. R. 17 E.
6 miles NW of Columbia
 (distance) (direction) (nearest town)

WELL PURPOSE: home
 (home, irrigation, municipal, industrial)

- WELL COMPLETION DATA:
- (1) diameter (inches) 4"
 - (2) total depth (feet) 100 ft.
 - (3) static water level (feet) 35 below above top of ground.
 - (4) casing PVC 40, 100 ft.
 (material) (depth)
4" if telescope see back.
 (size)
 - (5) screen 10", 90
 (length) (depth to top)
4", PVC
 (size) (material)
 - (6) pump 1/2
 (HP) (yield gpm)
220
 (type power)
 - (7) electric log (yes or no) _____
 (organization running log) _____
 - (8) how well bottom plugged _____

RECEIVED
APR 23 1990

Department of Natural Resources
 Bureau of Land & Water Resources

DRILLERS REMARKS:


If well telescopes please sketch and show depths.

GROUND LEVEL

100ft

10ft
Screen

If more than one screen,
show locations of each on sketch.

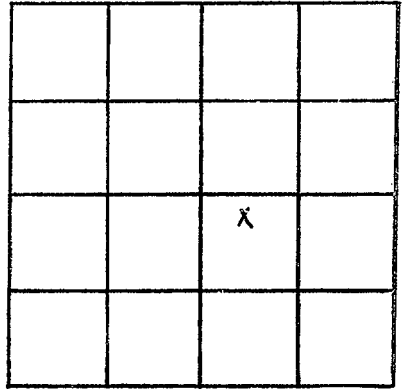

SECTION 20

Please indicate well location X.

ADDITIONAL INFORMATION

A series of horizontal lines for writing additional information.