

**MISSISSIPPI DEPARTMENT OF ENVIRONMENTAL QUALITY**

Office of Land and Water Resources

P. O. Box 10631  
Jackson, MS 39289-0631  
**WATER WELL DRILLERS LOG**

COUNTY WELL LOCATED <i>Monroe</i>	
WELL NUMBER <i>M 2067</i>	CODED
DATE WELL COMPLETED <i>5-9-95</i>	

PERMIT NUMBER <i>0-586</i>
NAME OF DRILLING FIRM <i>James Wells</i>
<i>Water Well Co</i>

NAME & MAILING ADDRESS OF LANDOWNER <i>Vernon Moody</i>		
<i>831 Pine Burr Rd.</i>		
<i>Columbia Miss 39429</i>		
WELL LOCATION: SEC	TOWNSHIP	RANGE
<i>26</i>	<i>3</i>	<i>17</i>
	<i>N</i> <i>S</i>	<i>E</i> <i>W</i>
DISTANCE	DIRECTION	NEAREST TOWN
<i>8</i> Miles	<i>South</i> of	<i>Columbia</i>
OTHER LANDMARK <i>Powell RD.</i>		
WELL PURPOSE: <input checked="" type="radio"/> Home Irrigation, Municipal, Industrial, Fish Pond, etc.		

PUMP DATA		
PUMP TYPE (Circle One): <input checked="" type="radio"/> Submersible, Turbine, Jet, Flowing Well, Other (Describe) _____		
PUMP TYPE (Circle One): <input checked="" type="radio"/> Electric, Tractor, Diesel, Gasoline, Butane, Other (Describe) _____ H/P <i>1</i>		
Pump Capacity (GPM)	No. of Stages	Setting Depth
		FT.
PUMP TEST		
Well yielded <i>15</i> GPM with a drawdown of _____ ft. after _____ hours of pumping		

WELL DATA		
Well Depth <i>115 FT</i>	Casing Diameter (In.) <i>4 in</i>	Casing Length (Ft.) <i>95</i>
Type of Casing <i>PVC</i>	Hole Depth <i>115 FT</i>	Depth to Static Water Level <i>65</i>
TYPE OF COMPLETION: (Circle One or More): <input checked="" type="radio"/> Gravel Packed, Underreamed, Telescoped, <input type="radio"/> Natural Development, <input type="radio"/> Open Hole, <input type="radio"/> Other (Describe) _____		

LOG DATA	
TYPE OF LOG RUN (Circle One): <input type="radio"/> No Log Run, <input type="radio"/> Electric, <input type="radio"/> Gamma Ray, <input type="radio"/> Density, <input type="radio"/> Sonic, <input type="radio"/> Neutron, Other (Describe) _____	
Name of Organization Running Log	

WELL GROUTED TO A DEPTH OF _____ FEET Type Grout (circle one): <input checked="" type="radio"/> Cement, <input type="radio"/> Bentonite, or Mix
--

GEOLOGIC DATA (Office Use Only)			
Surface Elev.	Geologic Unit	Unit Thickness	Depth to Top
Subs. SWL	Date	Analysis	Aquifer Test

SCREEN DATA		
Diameter - Inches <i>4 in</i>	Length - Feet <i>20</i>	Slot Size - Inches <i>.010</i>
Screen Type <i>PVC SLOT</i>	Depth to Bottom - Feet <i>95-115</i>	


Driller's Remarks	
Top of Lap Pipe or Reduction in Casing	
FEET	IF TELESCOPED OR MORE THAN ONE SCREEN: USE BACK PAGE

DESCRIPTION OF FORMATIONS ENCOUNTERED	FROM	TO
<i>Top Soil</i>	<i>0</i>	<i>3</i>
<i>Clay</i>	<i>3</i>	<i>30</i>
<i>Sand</i>	<i>30</i>	<i>50</i>
<i>Clay</i>	<i>50</i>	<i>70</i>
<i>Sand</i>	<i>70</i>	<i>115</i>

FORMATIONS (Continued)	FROM	TO
<b>RECEIVED</b>		
JUN 02 1995		
Dept. of Environmental Quality Office of Land & Water Resources		
IF MORE SPACE IS NEEDED, USE BACK		

If well telescopes please sketch and show depths.

GROUND LEVEL

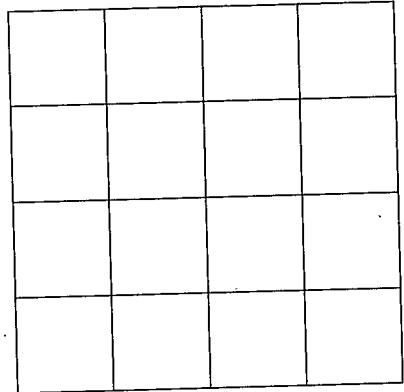

SECTION \_\_\_\_\_

Please indicate well location X.

ADDITIONAL INFORMATION

If more than one screen,  
show location of each on sketch.