

Marion
 N
 11-10-75

MISSISSIPPI
 BOARD OF WATER COMMISSIONERS
 416 North State Street
 Jackson, Mississippi 39201

WATER WELL DRILLERS LOG

11-10 1975 Hollinger Plumb Marion
 date well completed firm name county well located

LANDOWNER: Elma Pittman
 Route 2
 Foxworth, Miss 39483
 (mailing address)

description of formations encountered	from	to
	SAND	0
GRAVEL	15	31
CHALK	31	35
GRAVEL & SAND	35	50

WELL LOCATION:
 sec. — T — N R — E
 S W
 6 miles South of Foxworth
 (distance) (direction) (nearest town)

WELL PURPOSE: Home
 (home, irrigation, municipal, industrial)


- WELL COMPLETION DATA:
- (1) diameter (inches) 2" well
 - (2) total depth (feet) 50 ft.
 - (3) static water level (feet) 8 below top of ground.
 - (4) casing sced 40 pl. 50 (material) (depth)
 - _____ if telescope see back. (size)
 - (5) screen 5 ft. 45 (length) (depth to top)
 - 2" sced. 40 plast. (size) (material)
 - (6) pump 1/3 9 gal. (HP) (yield gpm)
 - elect. (type power)
 - (7) electric log No (yes or no)
 - None (organization running log)
 - (8) how well bottom plugged SAND SHARK

DRILLERS REMARKS: Good Well

DEC 10 1975
 MISS. BD. OF WATER COMMISSIONERS

If well telescopes please sketch and show depths.

GROUND LEVEL

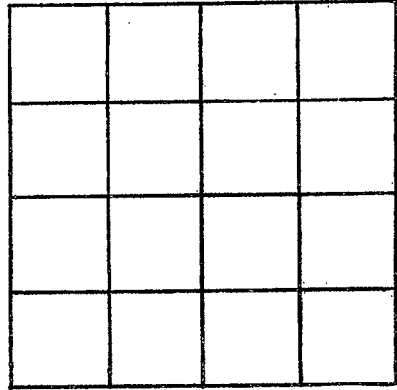

SECTION _____

Please indicate well location X.

ADDITIONAL INFORMATION

If more than one screen, show locations of each on sketch.