

*KN 12*  
*6-7-62*

WATER WELL DRILLERS LOG

CODED

Date: *6-7*, 19*62*, Driller: *S. S. Raine* County *Marion*  
(Name)

(1) Owner of Land: *William C. Jorgensen*  
(Name)  
*Tratworth Miss*  
(Address)  
*6. 2 13*

(2) Location:  $\frac{1}{4}$ ,  $\frac{1}{4}$ , Sec. *6. 2 13* T R  
*12* miles \_\_\_\_\_, of \_\_\_\_\_  
(distance) (direction) (Nearest Town)

(3) Topography: \_\_\_\_\_  
(Hilly) (Flat) (Level)

(4) Purpose of Well: *Domestic*  
(Domestic Irrigation  
Municipal, Industrial, Other)

Description & Color of Materials Sand, Clay, Red Clay, Shell, etc.	Thick- ness Feet	Depth Feet
<i>30 feet Red sand</i>		
<i>80 shell</i>		
<i>20 water sand</i>		
CODED		

Information upon completion of well:

(1) Diameter *2* inches.

(2) Total Depth *130* feet.

(3) Water Level *1000* feet below top of ground.

(4) Cased to *124*, Size *2*


(5) Screen: Size *2*, Length *60 feet*

(6) Were any formations sealed against pollution?  
\_\_\_\_\_ yes, *0* no.

If YES depth of formation \_\_\_\_\_

Why \_\_\_\_\_

Drillers Remarks: \_\_\_\_\_

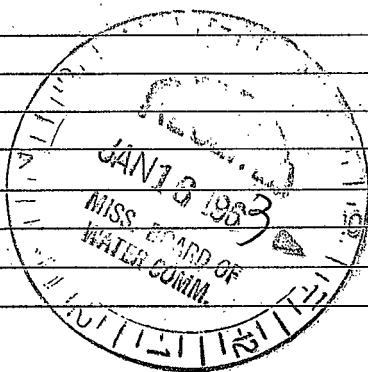

(Use Back Side)

Well No.

