

Marion
N 13

12-66 MISSISSIPPI BOARD OF WATER COMMISSIONERS

WATER WELL DRILLERS LOG

CODED

Date: 12-6-66, 19 66, Driller: W J Fitzgerald County: Marion
(When well drilled) (Name) (Where well is located)

Owner of Land: Theodore Bullock
(Name)
RT 2 Tipton
(Address)
Location: SE 1/4 SE 1/4, Sec. 15, T. 2, R. 12
12 miles SE of Tipton
(distance) (direction) (Nearest Town)
Topography: Hilly
(Hilly) (Flat) (Level)
Purpose of Well: Domestic
(Domestic Irrigation Municipal, Industrial, Other)

Description & Color of Materials Sand, Clay, Red Clay, Shell, etc.,	Thick- ness Feet	Depth Feet
<u>Top Soil Clay</u>	<u>10</u>	<u>20</u>
<u>Red Sand</u>	<u>14</u>	<u>34</u>
<u>Heavy gravel</u>	<u>6</u>	<u>40</u>
<u>Fine Red Sand</u>	<u>20</u>	<u>60</u>
<u>Shale</u>	<u>3</u>	<u>63</u>
<u>White Sand</u>	<u>27</u>	<u>90</u>
<u>Deep gravel</u>	<u>11</u>	<u>101</u>


CODED

Information upon completion of well:

Diameter 4 inches.
Total Depth 101 feet.
Water Level 60 feet below top of ground.
Cased to 93, Size 4
Screen: Size 4, Length 8
Were any formations sealed against pollution?
yes, no.

ES depth of formation _____

Remarks: _____
Yield in gpm: 250
Type pump: Electric
Horse power: _____

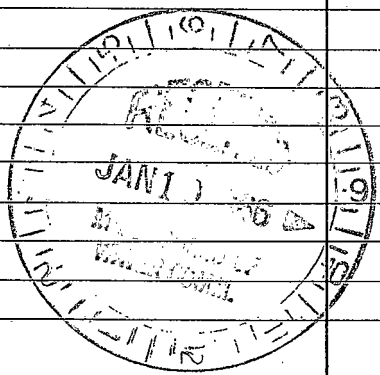

Return this copy to Board of Water Commissioners 429 Miss. St. Jackson, Miss.

