

Date: 5-20-66 1966, Driller: L. W. SHEPARD CODED MARION

(Name)

(1) Owner of Land: Charles Ervin
(Name)

(Address)

(2) Location: 1/4, 1/4, Sec. 13 T. 13 N. R. 13
10 miles S, of T. 13 N.
(distance) (direction) (Nearest Town)

(3) Topography: ✓
(Hilly) (Flat) (Level)

(4) Purpose of Well: Domestic
(Domestic Irrigation
Municipal, Industrial, Other)

Description & Color of Materials
Sand, Clay, Red Clay, Shell, etc.

Thick-
ness
Feet

Depth
Feet

SAND &
GRAVEL

82

Information upon completion of well:


- (1) Diameter 2" inches.
- (2) Total Depth 82 feet.
- (3) Water Level 36 feet below top of ground.
- (4) Cased to 82, Size 2"
- (5) Screen: Size 2", Length 3'
- (6) Were any formations sealed against pollution?
_____ yes, ✓ no.

If YES depth of formation _____

Why _____

Drillers Remarks: _____

CODED

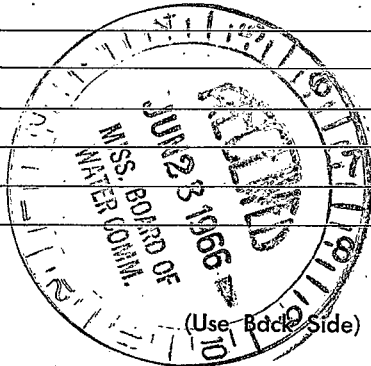

Well No.

1952