

N 17

6-13-66

WATER WELL DRILLERS LOG

CODED

Date: 6-13, 1966, Driller: E. B. SHERROD County MARION
 (Name)

(1) Owner of Land: <u>WALTHALL PITTMAN</u> (Name)	Description & Color of Materials Sand, Clay, Red Clay, Shell, etc.	Thick- ness Feet	Dep Feet
<u>Rt. 1 - Sandy Hook, Miss.</u> (Address)	<u>RED SANDY CLAY</u>	<u>60'</u>	
(2) Location: <u>1/4</u> , <u>1/4</u> , Sec. <u>4</u> <u>T. 2 N</u> <u>13</u> miles <u>S. W.</u> of <u>COLUMBIA</u> (distance) (direction) (Nearest Town)	<u>SAND & GRAVEL & CLAY STREAKS COARSE PEK GRAVEL & WHITE SAND</u>	<u>90'</u>	
(3) Topography: <u>V</u> (Hilly) (Flat) (Level)		<u>128</u>	
(4) Purpose of Well: <u>DOMESTIC</u> (Domestic Irrigation Municipal, Industrial, Other)	<u>CODED</u>		


Information upon completion of well:

- (1) Diameter 2 inches.
- (2) Total Depth 128 feet.
- (3) Water Level 80' feet below top of ground.
- (4) Cased to 128, Size 2".
- (5) Screen: Size 2, Length 3ft.
- (6) Were any formations sealed against pollution?
 _____ yes, no.

If YES depth of formation _____

Why _____

Drillers Remarks: _____

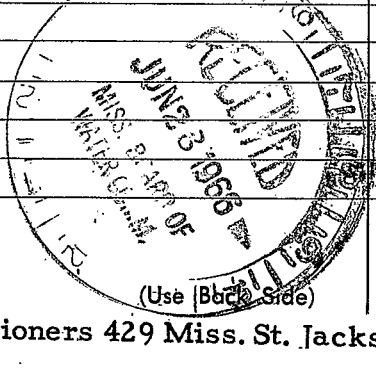

Well No. _____

The first part of the document discusses the importance of maintaining accurate records of all transactions. It emphasizes that every entry, no matter how small, should be recorded to ensure the integrity of the financial statements. This includes not only sales and purchases but also expenses and income.

The second part of the document provides a detailed breakdown of the accounting cycle. It outlines the ten steps involved in the process, from identifying the accounting entity to preparing financial statements. Each step is explained in detail, with examples provided to illustrate the concepts.

The third part of the document discusses the various types of accounts used in accounting. It categorizes accounts into assets, liabilities, equity, revenue, and expense accounts. It also explains the normal balances for each type of account and how they are used to calculate the net income or loss for a period.

The fourth part of the document discusses the importance of adjusting entries. It explains how these entries are used to ensure that the financial statements reflect the true financial position of the company at the end of the period. Examples of adjusting entries are provided to illustrate the process.

The fifth part of the document discusses the preparation of financial statements. It outlines the steps involved in preparing the balance sheet, income statement, and statement of owner's equity. It also discusses the importance of comparing the financial statements to the previous period to identify trends and changes.

The sixth part of the document discusses the importance of internal controls. It explains how these controls are used to prevent and detect errors and fraud. Examples of internal controls are provided to illustrate the process.

The seventh part of the document discusses the importance of ethics in accounting. It explains how accountants should maintain objectivity and integrity in their work. Examples of ethical dilemmas are provided to illustrate the process.

The eighth part of the document discusses the importance of communication in accounting. It explains how accountants should effectively communicate financial information to management and other stakeholders. Examples of communication scenarios are provided to illustrate the process.

The ninth part of the document discusses the importance of technology in accounting. It explains how accounting software and other technologies can be used to improve the efficiency and accuracy of the accounting process. Examples of technology applications are provided to illustrate the process.

The tenth part of the document discusses the importance of continuous learning in accounting. It explains how accountants should stay up-to-date on the latest developments in the field. Examples of learning opportunities are provided to illustrate the process.