

MARION

MISSISSIPPI BOARD OF WATER COMMISSIONERS

N 18

6-14-66

## WATER WELL DRILLERS LOG

Date: 6-14, 1966, Driller: E. B. SHEPARD County Marion  
(Name) CODED(1) Owner of Land: MARVIN HART  
(Name)RY 1 - SANDY Hook, Miss.  
(Address)(2) Location: 1/4, 1/4, Sec. 4 T2<sup>N</sup>R13<sup>E</sup>13 miles S. W. of COLUMBIA  
(distance) (direction) (Nearest Town)(3) Topography: \_\_\_\_\_  
(Hilly) (Flat) (Level)(4) Purpose of Well: DOMESTIC  
(Domestic Irrigation  
Municipal, Industrial, Other)

## Information upon completion of well:

(1) Diameter 2 inches.(2) Total Depth 129 feet.(3) Water Level 80 feet below top of ground.(4) Cased to 129', Size 2".(5) Screen: Size 2", Length 3ft.

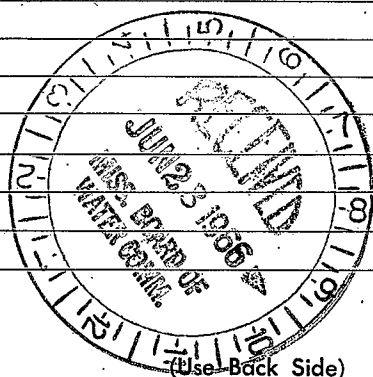
(6) Were any formations sealed against pollution?

\_\_\_\_\_ yes, ☒ no.

If YES depth of formation \_\_\_\_\_

Why \_\_\_\_\_

Drillers Remarks: \_\_\_\_\_

Description & Color of Materials  
Sand, Clay, Red Clay, Shell, etc.Thick-  
ness  
FeetDep  
FeRED SANDY  
CLAY55FINE SAND  
+ GUM LIKE  
CLAY85SANDY +  
DRY GRAVEL  
CODED95WATER GRAVEL  
+ COARSE SAND129

(Use Back Side)

Well No.

Retain this copy for your office files.

