

Marion
 N/A
 3-67

MISSISSIPPI
 BOARD OF WATER COMMISSIONERS CODED
 416 North State Street
 Jackson, Mississippi 39201

WATER WELL DRILLERS LOG

3/18 1967 date well completed
 Andy's Drilling Co. firm name
 Marion county well located

LANDOWNER: Herman Hunt
 Rt. 2 Foxworth, Miss.
 (mailing address)


description of formations encountered	from	to
Red Clay	0'	30'
Grey Clay	30'	90'
Sand	90'	100'
Chalk	100'	115'
Sand	115'	140'
Coarse Sand	140'	150'

WELL LOCATION:
 sec. 13 T. 2 N. R. 12 E.
 4 miles S.E. of Keokuk
 (distance) (direction) (nearest town)

WELL PURPOSE: Home
 (home, irrigation, municipal, industrial)


- WELL COMPLETION DATA:
- (1) diameter (inches) 4"
 - (2) total depth (feet) 150'
 - (3) static water level (feet) 90' below top of ground.
 - (4) casing P.V.C., 4" (material), 144' (depth)
 - (5) screen 6' (length), 1 44' (depth to top)
 - (6) pump 1/2 (HP), 10 (yield gpm)
 - (7) electric log No. (yes or no)
 - (8) how well bottom plugged Back Wash Valve

DRILLERS REMARKS:
 Submersible pump

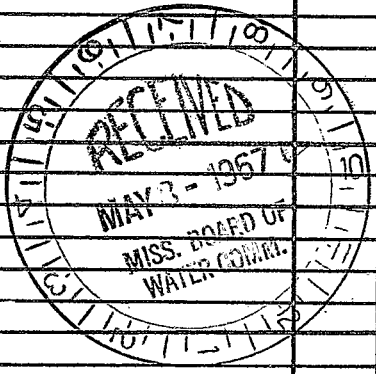

If well telescopes please sketch and show depths.

GROUND LEVEL

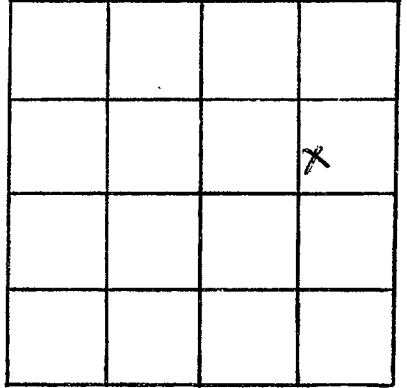

SECTION 13

Please indicate well location X.

ADDITIONAL INFORMATION

If more than one screen,
show locations of each on sketch.