

MARION
N20
6-67

MISSISSIPPI
BOARD OF WATER COMMISSIONERS
416 North State Street
Jackson, Mississippi 39201

CODED

WATER WELL DRILLERS LOG

6-16 1967 Reagan & Fowl Marion
date well completed firm name county well located

LANDOWNER: Ted Wilber

description of formations encountered

from to

Foxworth, Miss.

clay

0 100

gravel

100 168

pea gravel

168 200

(mailing address)

WELL LOCATION:

sec. 7 T. 20 N. R. 20 E. 13E
S S W
5 miles SE of Kokomo
(distance) (direction) (nearest town)

WELL PURPOSE:

(home, irrigation, municipal, industrial)

CODED

WELL COMPLETION DATA:

(1) diameter (inches) 2"
(2) total depth (feet) 200'
(3) static water level (feet) 32' below top of ground.

(4) casing Gal. 197'
(material) (depth)

(size) if telescope see back.

(5) screen 3' 197'
(length) (depth to top)

.01" Stainless Steel
(size) (material)

(6) pump 1/2 (HP) (yield gpm)

Elect
(type power)

(7) electric log no
(yes or no)

(organization running log)

(8) how well bottom plugged back
wash valve


DRILLERS REMARKS:

SUN-5-1968
MISS. BOARD OF
WATER COMMISSIONERS

If well telescopes please sketch and show depths.

GROUND LEVEL

N

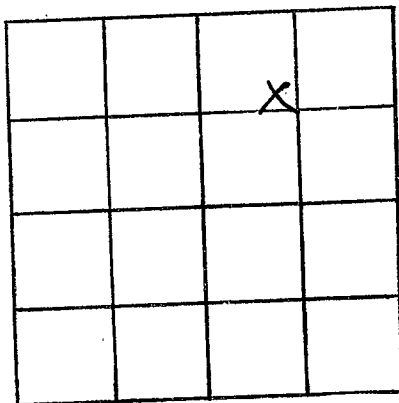

SECTION 7

Please indicate well location X.

ADDITIONAL INFORMATION

If more than one screen, show locations of each on sketch.