

Marion
N 21
7-68

MISSISSIPPI
BOARD OF WATER COMMISSIONERS
416 North State Street
Jackson, Mississippi 39201

CODED

WATER WELL DRILLERS LOG

7-3 1968 Reagan & Fails Marion
date well completed firm name county well located

LANDOWNER: George Sellers

description of formations encountered

from to

Julesburg, Miss.

Clay 0 40
Sand & pea gravel 40 70

(mailing address)

WELL LOCATION:

sec. 9 T. 2 N R. 12 E
S W
4 1/2 miles S of Hobbes
(distance) (direction) (nearest town)

CODED

WELL PURPOSE: home
(home) irrigation, municipal, industrial


WELL COMPLETION DATA:

- (1) diameter (inches) 4"
- (2) total depth (feet) 70'
- (3) static water level (feet) 30' ^{below} _{above} top of ground.
- (4) casing plast. 22
(material) (depth)
- if telescope see back.
(size)
- (5) screen 8' 62'
(length) (depth to top)
- 008 plast.
(size) (material)
- (6) pump 3/4
(HP) (yield gpm)
- elect
(type power)
- (7) electric log no
(yes or no)

(organization running log)

(8) how well bottom plugged Back wash valve

DRILLERS REMARKS:

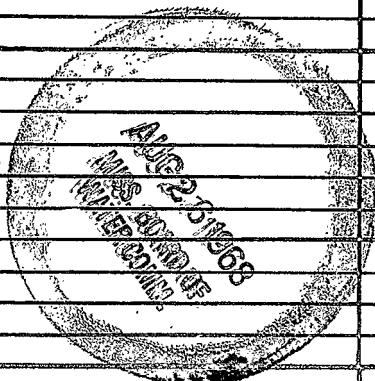

If well telescopes please sketch and show depths.

GROUND LEVEL

SECTION _____

Please indicate well location X.

ADDITIONAL INFORMATION

If more than one screen, show locations of each on sketch.