

MARION MISSISSIPPI BOARD OF WATER COMMISSIONERS

~~Q~~ N 22  
1-21-65

WATER WELL DRILLERS LOG <sup>CODED</sup>

Date: 1-21, 1965, Driller: S S Rouse County MARION  
(Name)


(1) Owner of Land: <u>Everett Strayer</u> (Name)	Description & Color of Materials Sand, Clay, Red Clay, Shell, etc.	Thick- ness Feet	Depth Feet
<u>FOXWORTH MISS.</u> (Address)			
(2) Location: <u>1/4</u> , <u>1/4</u> , Sec. <u>16</u> <u>T-2</u> <u>R-13</u>	<u>20 feet Red clay</u>		
<u>7</u> miles <u>S.E.</u> , of <u>FOXWORTH</u> (distance) (direction) (Nearest Town)	<u>1.10 feet Red sand</u>		
(3) Topography: <input checked="" type="checkbox"/> (Hilly) <input type="checkbox"/> (Flat) <input type="checkbox"/> (Level)			
(4) Purpose of Well: <u>DOMESTIC</u> (Domestic Irrigation Municipal, Industrial, Other)	<u>30 feet water sand</u>		

Information upon completion of well:

- (1) Diameter 4 inches.
- (2) Total Depth 160 feet.
- (3) Water Level 120 feet below top of ground.
- (4) Cased to 154", Size 4"
- (5) Screen: Size 4, Length 6
- (6) Were any formations sealed against pollution?  
\_\_\_\_\_ yes,  no.

If YES depth of formation \_\_\_\_\_  
Why \_\_\_\_\_

Drillers Remarks: \_\_\_\_\_

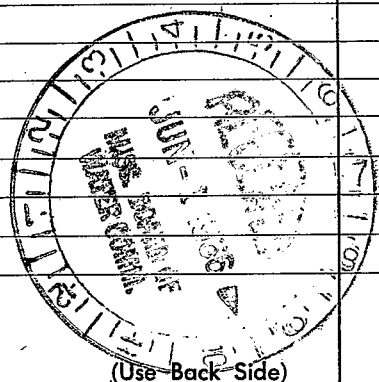

(Use Back Side)

Well No.

