

CODED

MARION  
N 25  
1-20-70

MISSISSIPPI  
BOARD OF WATER COMMISSIONERS  
416 North State Street  
Jackson, Mississippi 39201

WATER WELL DRILLERS LOG

Jan 20 1970 Evolex Stafford Water Well Service Marion  
date well completed firm name county well located

LANDOWNER:

Edie Hollander  
Trillock, Miss  
Rt # 3  
(mailing address)

Description of formations encountered

from to

Chalk

0 20ft

Sand & Gravel

20 85ft

WELL LOCATION:

sec 4 T 2 N R 13 E  
10 miles West of Chenow  
(distance) (direction) (nearest town)

WELL PURPOSE:

(home, irrigation, municipal, industrial)

WELL COMPLETION DATA:

- (1) diameter (inches) 4 in
- (2) total depth (feet) 85 ft
- (3) static water level (feet) 40 below above top of ground.
- (4) casing Plastic, 75 ft  
(material) (depth)  
4 in if telescope see back.  
(size)
- (5) screen 10 ft, 75 ft  
(length) (depth to top)  
4 in, Plastic  
(size) (material)
- (6) pump \_\_\_\_\_ (HP) \_\_\_\_\_ (yield gpm)  
(type power)
- (7) electric log No  
(yes or no)  
(organization running log)
- (8) how well bottom plugged B.W.V

DRILLERS REMARKS:


Charles Stafford

FEB 16 1970

MISS. BD. OF  
WATER COMM.

If well telescopes please sketch and show depths.

GROUND LEVEL

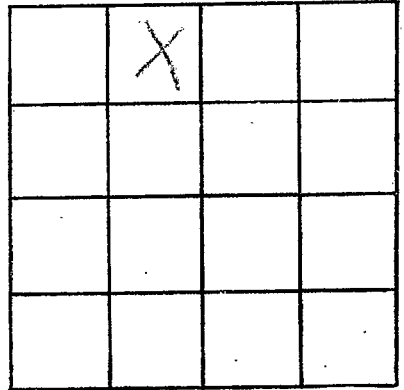

SECTION \_\_\_\_\_

Please indicate well location X.

ADDITIONAL INFORMATION

If more than one screen, show locations of each on sketch.