

Marion
 N 26
 5-5-69

MISSISSIPPI
 BOARD OF WATER COMMISSIONERS
 416 North State Street
 Jackson, Mississippi 39201

CODED

WATER WELL DRILLERS LOG

5/5 1969 Dean Grimes Marion
 date well completed firm name county well located

LANDOWNER:

Fester Bedwell,
 Route 2, Foxworth, Miss.
 (mailing address)

description of formations encountered

from to

WELL LOCATION:

sec. 1 T 20 S R 12 E W
 7 1/2 miles S of Foxworth
 (distance) (direction) (nearest town)

WELL PURPOSE: Home Use
 (home, irrigation, municipal, industrial)

WELL COMPLETION DATA:

- (1) diameter (inches) 2"
- (2) total depth (feet) 244'
- (3) static water level (feet) 147 below top of ground.
- (4) casing Plastic, 238' (material) (depth)
 (size) if telescope see back.
- (5) screen 4' 240' (length) (depth to top)
 2" S.S. Strainer (size) (material)
- (6) pump 2 HP (HP) (yield gpm)
 Mould jet pump (type power)
- (7) electric log No (yes or no)
 (organization running log)
- (8) how well bottom plugged

description of formations encountered	from	to
Top soil	0	1
Red Clay	1	25
Red sand	25	60
Gravel	60	90
Chalk	90	180
fine sand	180	210
Water sand	120	204

CODED


MAR 18 1970

MISS. BD. OF WATER COMM.

DRILLERS REMARKS:

If well telescopes please sketch and show depths.

GROUND LEVEL

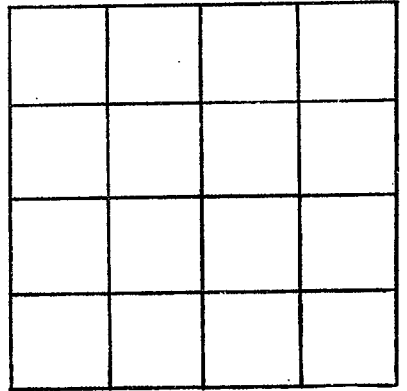

SECTION _____

Please indicate well location X.

ADDITIONAL INFORMATION

If more than one screen, show locations of each on sketch.