

MISSISSIPPI
BOARD OF WATER COMMISSIONERS
416 North State Street
Jackson, Mississippi 39201

CODED

WATER WELL DRILLERS LOG

Marion
N 27
5-30-69

5/30 1969 Dean Grimes Marion
date well completed firm name county well located

LANDOWNER:

B. J. McKezie
Route 2, Foxworth, Miss.
(mailing address)

description of formations encountered

from to

Top soil 0-1
Red Clay 1-30
Gravel 30-65
Chalk 65-115
Gravel 115-135
Sand 135-185
Coarse Water Sand 185-210

WELL LOCATION:

sec 20 T2 N R 13 E S
4 1/2 miles S of Church
(distance) (direction) (nearest town)

WELL PURPOSE: Home Use
(home, irrigation, municipal, industrial)

WELL COMPLETION DATA:

- (1) diameter (inches) 4
- (2) total depth (feet) 210
- (3) static water level (feet) 140 below above top of ground.
- (4) casing Plastic, 200' (material) (depth)
- (size) if telescope see back.
- (5) screen 10, 200' (length) (depth to top)
- 4" Plastic (size) (material)
- (6) pump 1/4 HP (HP) (yield gpm)
- McDonald sub pump (type power)
- (7) electric log No (yes or no)

(organization running log)

(8) how well bottom plugged


DRILLERS REMARKS:

MAR 18 1970

MISS. BD. OF
WATER COMM.

If well telescopes please sketch and show depths.

GROUND LEVEL

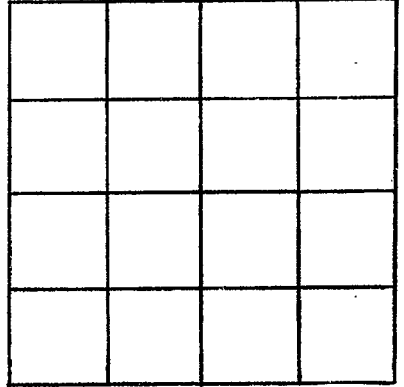

SECTION _____

Please indicate well location X.

ADDITIONAL INFORMATION

If more than one screen, show locations of each on sketch.