

Marion
 N 28
 6-16-69

MISSISSIPPI
 BOARD OF WATER COMMISSIONERS
 416 North State Street
 Jackson, Mississippi 39201

COPIED

WATER WELL DRILLERS LOG

6-16 1969 Des Moines Marion
 date well completed firm name county well located

LANDOWNER:

Mack J. Bracey
 Route 2, Fyersboro, Miss.
 (mailing address)

description of formations encountered

from to

WELL LOCATION:

sec. 10 T. 2 N. R. 12 E.
 S W
 16 miles S E of Columbus
 (distance) (direction) (nearest town)

WELL PURPOSE:

Home Use
 (home, irrigation, municipal, industrial)

WELL COMPLETION DATA:

- (1) diameter (inches) 4"
- (2) total depth (feet) 112'
- (3) static water level (feet) 66 below top of ground
- (4) casing Plastic 103' (material) (depth)
- (size) if telescope see back.
- (5) screen 10' (length) 103' (depth to top)
- 4" Plastic (size) (material)
- (6) pump 3/4 HP (HP) (yield gpm)
- Jacuzzi sub. pump (type power)
- (7) electric log No (yes or no)
- (organization running log)
- (8) how well bottom plugged

top soil	0-1
red clay	1-8
Red sand	8-20
Chalk	20-66
fine sand	66-90
Water sand	90-112

COPIED


MAR 18 1970

MISS. BD. OF WATER COMM.

DRILLERS REMARKS:

If well telescopes please sketch and show depths.

GROUND LEVEL

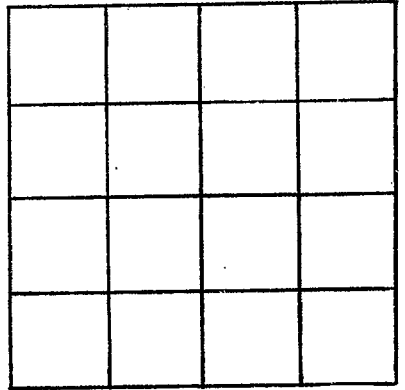

SECTION _____

Please indicate well location X.

ADDITIONAL INFORMATION

If more than one screen, show locations of each on sketch.