

Marion  
N 29  
10-27-69

MISSISSIPPI  
BOARD OF WATER COMMISSIONERS  
416 North State Street  
Jackson, Mississippi 39201

CODED

WATER WELL DRILLERS LOG

10-27 1969 Dean Griner Marion  
date well completed firm name county well located

LANDOWNER:  
Volpha Terrell  
Route 2 Popworth, Miss.  
(mailing address)

description of formations encountered	from	to
<u>Top soil</u>	<u>0</u>	<u>1</u>
<u>Red clay</u>	<u>1</u>	<u>30</u>
<u>Red sand</u>	<u>30</u>	<u>50</u>
<u>Gravel</u>	<u>50</u>	<u>135</u>
<u>Chalk</u>	<u>135</u>	<u>180</u>
<u>fine sand</u>	<u>180</u>	<u>195</u>
<u>water sand</u>	<u>195</u>	<u>216</u>

WELL LOCATION:  
sec 6 T 2 N R 13 E  
S W  
8 miles S of Popworth  
(distance) (direction) (nearest town)

WELL PURPOSE: Home Use  
(home, irrigation, municipal, industrial)

WELL COMPLETION DATA:  
(1) diameter (inches) 2"  
(2) total depth (feet) 216'  
(3) static water level (feet) \_\_\_\_\_ below  
above  
top of ground.  
(4) casing Galvanize 2 1/2'  
(material) (depth)  
(size) if telescope see back.  
(5) screen 4' 2 1/2  
(length) (depth to top)  
2" S.S. Strainer  
(size) (material)  
(6) pump 1/2 HP \_\_\_\_\_  
(HP) (yield gpm)  
McDonald rod pump  
(type power)  
(7) electric log No  
(yes or no)  
(organization running log) \_\_\_\_\_  
(8) how well bottom plugged \_\_\_\_\_

CODED


MAR 7 8 1970

MISS. BD. OF  
WATER COMM.

DRILLERS REMARKS:

If well telescopes please sketch and show depths.

GROUND LEVEL

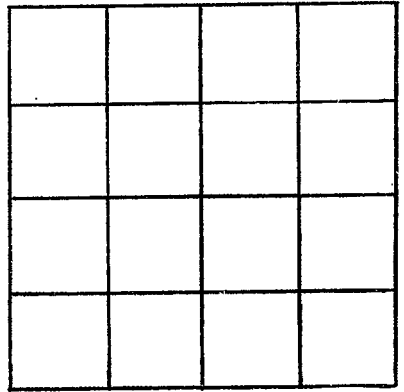

SECTION \_\_\_\_\_

Please indicate well location X.

ADDITIONAL INFORMATION

If more than one screen, show locations of each on sketch.