

Marion  
N 30  
12-12-69

MISSISSIPPI  
BOARD OF WATER COMMISSIONERS  
416 North State Street  
Jackson, Mississippi 39201

CODEL

WATER WELL DRILLERS LOG

12/12 1969 Dean Krimes Marion  
date well completed firm name county well located

LANDOWNER:

Wilmer M<sup>d</sup> Kenzie  
Route 2 Forwardth, Miss  
(mailing address)

description of formations encountered

from to

Top soil	0	1
Red clay	1	35
Yellow sand	35	70
Gravel	70	100
Chalk	100	120
Gravel	120	190
fine sand	190	200
water	200	214

WELL LOCATION:

sec 20 T 2 N R 13 E  
S W  
4 miles South of Cherow  
(distance) (direction) (nearest town)

WELL PURPOSE: Home  
(home, irrigation, municipal, industrial)

WELL COMPLETION DATA:

- (1) diameter (inches) 4"
- (2) total depth (feet) 214'
- (3) static water level (feet) \_\_\_\_\_ below/above top of ground.
- (4) casing Plastic, 204, (material) (depth)
- \_\_\_\_\_ if telescope see back. (size)
- (5) screen 10', 204 (length) (depth to top)  
4", Plastic (size) (material)
- (6) pump 1 H.P. (HP) (yield gpm)  
F.B.M. sub. pump (type power)
- (7) electric log NO (yes or no)
- \_\_\_\_\_ (organization running log)
- (8) how well bottom plugged \_\_\_\_\_


MAR 18 1970

MISS. BD. OF  
WATER COMM.

DRILLERS REMARKS:

If well telescopes please sketch and show depths.

GROUND LEVEL

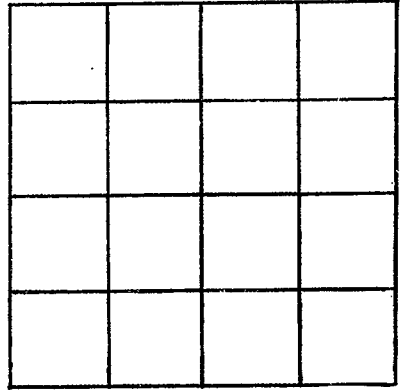

SECTION \_\_\_\_\_

Please indicate well location X.

ADDITIONAL INFORMATION

If more than one screen, show locations of each on sketch.