

Marion  
N 31  
12-26-69

MISSISSIPPI  
BOARD OF WATER COMMISSIONERS  
416 North State Street  
Jackson, Mississippi 39201

CODED

WATER WELL DRILLERS LOG

12/26 1969 Dean Series  
date well completed firm name county well located

LANDOWNER:

Other Stringer

description of formations encountered

Top soil

from to

0-1

Route 2, Fourwath, Miss  
(mailing address)

Red Clay

1-2.5

WELL LOCATION:

sec 20 T 2 W R 12 E  
S W  
4 1/2 miles S of Cheraw  
(distance) (direction) (nearest town)

Red sand

2.5-6.5

Gravel

6.5-9.5

Chalk

9.5-14.0

WELL PURPOSE: Home Use  
(home, irrigation, municipal, industrial)

fine sand

14.0-16.5

WELL COMPLETION DATA:

Coarse water sand

16.5-19.0

(1) diameter (inches) 4"

(2) total depth (feet) 190'

(3) static water level (feet) 140' below above top of ground.

(4) casing Plastic, 180'  
(material) (depth)

if telescope see back.  
(size)

(5) screen 10', 180'  
(length) (depth to top)

4", Plastic  
(size) (material)

(6) pump 1/2 HP  
(HP) (yield gpm)

5.0 M. sub. pump  
(type power)

(7) electric log NO  
(yes or no)

(organization running log)

(8) how well bottom plugged


MAR 18 1970

MISS. BD. OF  
WATER COMM.

DRILLERS REMARKS:

If well telescopes please sketch and show depths.

GROUND LEVEL

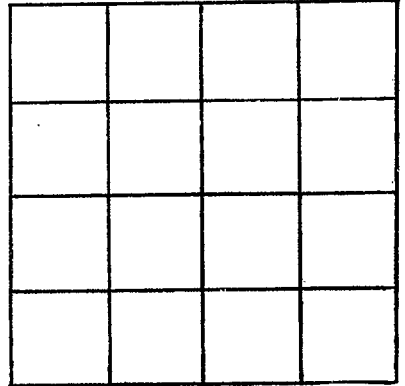

SECTION \_\_\_\_\_

Please indicate well location X.

ADDITIONAL INFORMATION

If more than one screen, show locations of each on sketch.