

**MISSISSIPPI
BOARD OF WATER COMMISSIONERS**
416 North State Street
Jackson, Mississippi 39201

WATER WELL DRILLERS LOG

CODE

MARION
N 32
1- 70

Jan. 1970 E. B. Sheppard Marion
date well completed firm name county well located

LANDOWNER:	description of formations encountered	from	to
<u>Ray DeAngelo</u> <u>Rt. 1 - Jopworth</u> <small>(mailing address)</small>	<u>MIXED CLAY</u> <u>SAND & GRAVEL</u> <u>SAND & GRAVEL</u>	<u>0</u> <u>90'</u> <u>90'</u>	<u></u> <u>90'</u> <u>144'</u>
WELL LOCATION: sec. <u>4</u> T. <u>2</u> N. R. <u>19</u> E. <u>7</u> miles <u>SW</u> of <u>Columbia</u> <small>(distance) (direction) (nearest town)</small>			
WELL PURPOSE: <u>(home, irrigation, municipal, industrial)</u>			
WELL COMPLETION DATA: (1) diameter (inches) <u>3"</u> (2) total depth (feet) <u>144'</u> (3) static water level (feet) <u>80</u> below above top of ground. (4) casing <u>Plastic</u> , <u>144'</u> <small>(material) (depth)</small> <u>2"</u> if telescope see back. <small>(size)</small> (5) screen <u>3'</u> , <u>2 1/2"</u> S.S. <small>(length) (depth to top) (size) (material)</small> (6) pump <u>1 1/2</u> <u>8</u> <small>(HP) (yield gpm)</small> <u></u> <small>(type power)</small> (7) electric log <u>(yes or no)</u> <u></u> <small>(organization running log)</small> (8) how well bottom plugged <u>BN</u>			
DRILLERS REMARKS:			


COPIED

FEB 5 - 1970

MISSISSIPPI
WATER BOARD

If well telescopes please sketch and show depths.

GROUND LEVEL

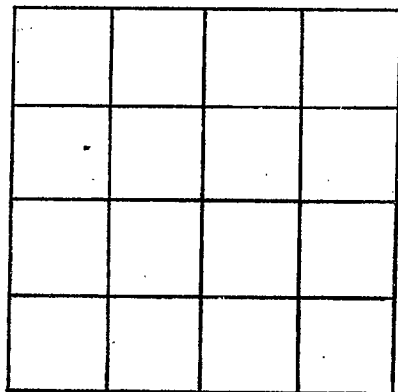

SECTION _____

Please indicate well location X.

ADDITIONAL INFORMATION

If more than one screen,
show locations of each on sketch.