

Marion
N 33
2-3-70

MISSISSIPPI
BOARD OF WATER COMMISSIONERS
416 North State Street
Jackson, Mississippi 39201

CODED

WATER WELL DRILLERS LOG

2/2 1970 Dean Shivers Marion
date well completed firm name county well located

LANDOWNER:
Mr. Doug Williamson
Route 2, Foworth, Miss.
(mailing address)

description of formations encountered	from	to
<u>Top soil</u>	<u>0</u>	<u>1'</u>
<u>Clay</u>	<u>1</u>	<u>5'</u>
<u>Chalk</u>	<u>5</u>	<u>15</u>
<u>red sand</u>	<u>15</u>	<u>20</u>
<u>fine white sand</u>	<u>20</u>	<u>30</u>
<u>Coarse water sand</u>	<u>30</u>	<u>45</u>

WELL LOCATION:
sec. 12 T 2 N R. 13 W
S W
1/4 mile miles east of Cherwell
(distance) (direction) (nearest town)

WELL PURPOSE: Home Use
(home, irrigation, municipal, industrial)

WELL COMPLETION DATA:
(1) diameter (inches) 2"
(2) total depth (feet) 45'
(3) static water level (feet) 18 below above top of ground.
(4) casing Plastic, 36'
(material) (depth)
(size) If telescope see back.
(5) screen 7', 38
(length) (depth to top)
2", Plastic
(size) (material)
(6) pump _____ (HP) (yield gpm)
Used old pump
(type power)
(7) electric log No
(yes or no)

(organization running log)

CODED

MAR 18 1970


MISS. BD. OF
WATER COMM.

(8) how well bottom plugged _____

DRILLERS REMARKS: _____

If well telescopes please sketch and show depths.

GROUND LEVEL

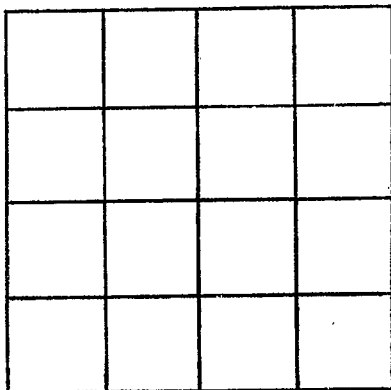

SECTION _____

Please indicate well location X.

ADDITIONAL INFORMATION

If more than one screen, show locations of each on sketch.