

Marion
N 34
3-70

MISSISSIPPI
BOARD OF WATER COMMISSIONERS
416 North State Street
Jackson, Mississippi 39201

CODEL

WATER WELL DRILLERS LOG

March 1970 E.B. Sheppard Marion
date well completed firm name county well located

LANDOWNER:	description of formations encountered	from	to
John McCain	SANDY RED CLAY	0	70
Landy Hook, Miss. (mailing address)	LOOSE GRAVEL + SAND	70	120
WELL LOCATION: sec 29 T 2 N R 13 E 10 miles SW of Columbia (distance) (direction) (nearest town)	MIXTURE OF GRAVEL + COARSE SAND	120	152
WELL PURPOSE: (home, irrigation, municipal, industrial)	HARD CLAY STREAK ON BOTTOM AND THEN BACK INTO FINE SAND.		
WELL COMPLETION DATA:			
(1) diameter (inches) 2"			
(2) total depth (feet) 152'			
(3) static water level (feet) 120 below top of ground			
(4) casing (material) (depth) 152'			
2" if telescope see back. (size)			
(5) screen (length) (depth to top) 3'			
2 1/2" S.S. (size) (material)			
(6) pump (HP) (yield gpm) 1 1/2 7			
E (type power)			
(7) electric log (yes or no) (organization running log)			
(8) how well bottom plugged BWV			

CODEL


MAR 17 1970

MISC. RD. OF
WATER COMM.

DRILLERS REMARKS:

If well telescopes please sketch and show depths.

GROUND LEVEL

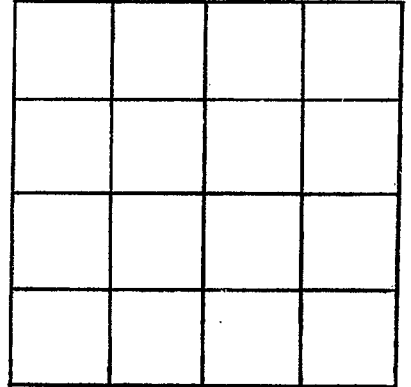

SECTION _____

Please indicate well location X.

ADDITIONAL INFORMATION

If more than one screen,
show locations of each on sketch.