

Marion
N 36
3-12-70

MISSISSIPPI
BOARD OF WATER COMMISSIONERS
416 North State Street
Jackson, Mississippi 39201

COPED

WATER WELL DRILLERS LOG

3 12

date well completed

1970 Early Stafford Well Ser.

firm name

Marion

county well located

LANDOWNER: Joe May
Route 2

(mailing address)

description of formations
encountered

from

to

Topsoil + Chalk

0 30 ft

WELL LOCATION:

sec. 10 T 2 N R 12 E

1 1/2 miles North of Chesaw
(distance) (direction) (nearest town)

WELL PURPOSE:

(home, irrigation, municipal, industrial)

WELL COMPLETION DATA:

- (1) diameter (inches) 4 in
(2) total depth (feet) 126
(3) static water level (feet) below
top of ground.
(4) casing Plastic, 116
(material) (depth)
4 in if telescope see back.
(size)
(5) screen 10 ft, 116 ft
(length) (depth to top)
4 in, Plastic
(size) (material)
(6) pump 1 hp
(HP) (yield gpm)
elec.
(type power)
(7) electric log
(yes or no)

(organization running log)

(8) how well bottom plugged

R.W.V.

DRILLERS REMARKS:


Charles Stafford

MAY

REC'D. Bd. of
WATER COM.

If well telescopes please
sketch and show depths.

GROUND LEVEL

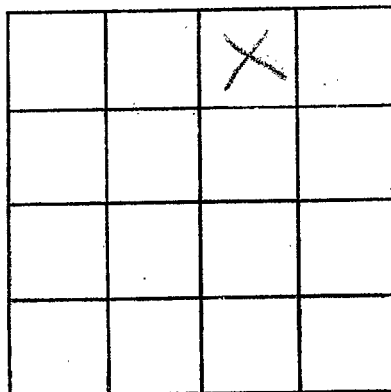

SECTION _____

Please indicate well location X.

ADDITIONAL INFORMATION

If more than one screen,
show locations of each on sketch.