

MISSISSIPPI
BOARD OF WATER COMMISSIONERS
416 North State Street
Jackson, Mississippi 39201

CODED

WATER WELL DRILLERS LOG

MARION
N37
8-28-70

August 28 1970 Lewis Crain Water Well Marion
date well completed firm name county well located

LANDOWNER:
W. V. Crain
Route 2, Fplertown, Mich.
(mailing address)

description of formations encountered	from	to
top soil	0	1'
red clay	1'	7'
red sand	7'	35'
gravel	35'	60'
Chalk	60'	110'
fine sand	110'	123'
water sand	123'	153'

WELL LOCATION:
sec. 5 T 2 N R 19 E
10 miles south of Foworth
(distance) (direction) (nearest town)

WELL PURPOSE: Home Use
(home, irrigation, municipal, industrial)

- WELL COMPLETION DATA:
- (1) diameter (inches) 4"
 - (2) total depth (feet) 153'
 - (3) static water level (feet) 84' below top of ground.
 - (4) casing Plastic, 143' (material) (depth)
4" if telescope see back. (size)
 - (5) screen 10' length, 143' depth to top
4" Plastic (size) (material)
 - (6) pump 1/2 HP, sub pump (HP) (field gpm)
(type power)
 - (7) electric log No (yes or no)
(organization running log)
 - (8) how well bottom plugged

CODED


SEP 2 1970

DRILLERS REMARKS:

MISS. BD. OF
WATER COMM.

If well telescopes please sketch and show depths.

GROUND LEVEL

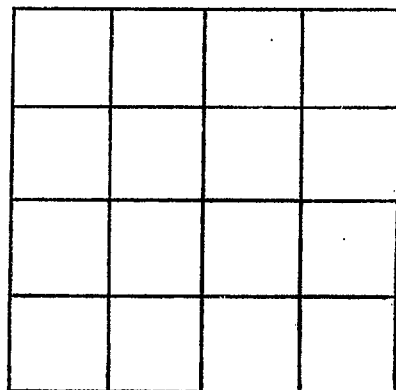

SECTION _____

Please indicate well location X.

ADDITIONAL INFORMATION

If more than one screen,
show locations of each on sketch.