

MARION
 N 38
 8-20-70

MISSISSIPPI
 BOARD OF WATER COMMISSIONERS
 416 North State Street
 Jackson, Mississippi 39201

CODED

WATER WELL DRILLERS LOG

August 20 1970 R. Woodward Drilling Marion
 date well completed firm name county well located

LANDOWNER: <u>Horace McKenzie</u>	description of formations encountered	from	to
	<u>Sand and Gravel</u>		<u>14'</u>
<u>Sandy Hook Miss</u> (mailing address)	<u>Clay</u>	<u>14'</u>	<u>21'</u>
WELL LOCATION: sec. <u>2</u> T. <u>2</u> N. R. <u>13</u> E. S. <u>4</u>	<u>Sand</u>	<u>21</u>	<u>23</u>
<u>1/2</u> miles <u>NW</u> of <u>Sandyhook</u> (distance) (direction) (nearest town)	<u>Hard Rock</u>	<u>23</u>	<u>24</u>
WELL PURPOSE: (home, irrigation, municipal, industrial)	<u>Sand</u>	<u>24</u>	<u>26</u>
WELL COMPLETION DATA: (1) diameter (inches) <u>4"</u>	<u>Hard rock in stages</u>	<u>26</u>	<u>38'</u>
(2) total depth (feet) <u>140</u>	<u>of 1-2' each</u>		
(3) static water level (feet) <u>110'</u> below top of ground.	<u>Sand and Gravel</u>	<u>38</u>	<u>142</u>
(4) casing <u>Plastic</u> , <u>125'</u> (material) (depth)			
<u>4"</u> if telescope see back. (size)			
(5) screen <u>15'</u> <u>125'</u> (length) (depth to top)			
<u>4"</u> <u>Plastic</u> (size) (material)			
(6) pump <u>3/4</u> <u>10.4</u> (HP) (yield gpm)			
<u>220V AC</u> (type power)			
(7) electric log <u>No</u> (yes or no)			
(organization running log)			
(8) how well bottom plugged <u>Float</u> <u>Type Bachman valve</u>			
DRILLERS REMARKS:			


CODED

SEP 18 1970

MISS. BD. OF
 WATER COMMISSIONERS

If well telescopes please sketch and show depths.

GROUND LEVEL

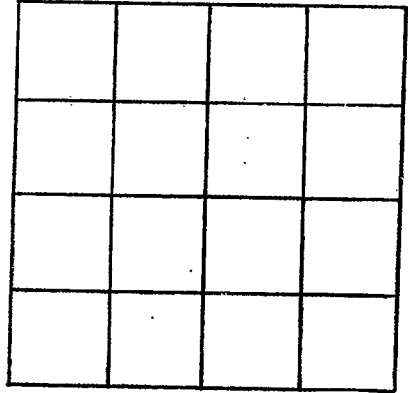

SECTION _____

Please indicate well location X.

ADDITIONAL INFORMATION

Lined area for additional information.

If more than one screen, show locations of each on sketch.