

MISSISSIPPI
BOARD OF WATER COMMISSIONERS
416 North State Street
Jackson, Mississippi 39201

CODED

WATER WELL DRILLERS LOG

MARION
N41
7-20

July 1970 E.B. SHEPPARD MARION
date well completed firm name county well located

LANDOWNER:	description of formations encountered	from	to
ALDEN MCKENZIE Rt. 2 - Foxworth, Miss. (mailing address)			
WELL LOCATION:			
sec. 28 T. 2 N. R. 19 E. 23 S. W.			
11 miles S of Columbia (distance) (direction) (nearest town)			
WELL PURPOSE:			
(home) irrigation, municipal, industrial			
WELL COMPLETION DATA:			
(1) diameter (inches) 2"	CODED		
(2) total depth (feet) 100			
(3) static water level (feet) 38 below top of ground.			
(4) casing PLASTIC, 95' (material) (depth)			
2" if telescope see back. (size)			
(5) screen 3' (length) (depth to top)			
2" S.S. (size) (material)			
(6) pump 3/4 8 (HP) (yield gpm)			
E (type power)			
(7) electric log (yes or no)			
(organization running log)			
(8) how well bottom plugged BWV			


AUG 13 1970

DRILLERS REMARKS:

MISS. BD. OF

If well telescopes please sketch and show depths.

GROUND LEVEL

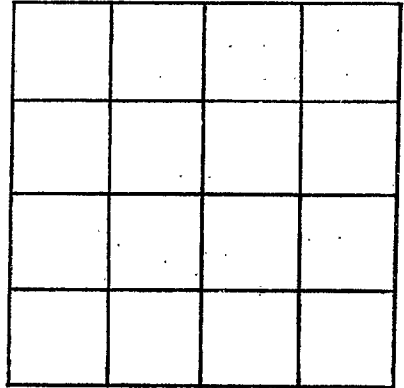

SECTION _____

Please indicate well location X.

ADDITIONAL INFORMATION

If more than one screen, show locations of each on sketch.