

MISSISSIPPI
BOARD OF WATER COMMISSIONERS
416 North State Street
Jackson, Mississippi 39201

CODED

WATER WELL DRILLERS LOG

MARION
N 42
8-5-70

August 5th 1970 Lesum Strainer Well Service Marion
date well completed firm name county well located

LANDOWNER:	description of formations encountered	from	to
<u>Marion Stogues</u> <u>Route 2, Fort Worth, Miss.</u> (mailing address)			
<u>5 miles S.E. of Robinson</u> (distance) (direction) (nearest town)	<u>red clay</u>	<u>1</u>	<u>6'</u>
WELL LOCATION: sec. <u>15</u> T. <u>2</u> N. R. <u>5</u> E. <u>5</u> miles S.E. of <u>Robinson</u> (distance) (direction) (nearest town)	<u>sand</u>	<u>6</u>	<u>30</u>
WELL PURPOSE: <u>Home Use</u> (home, irrigation, municipal, industrial)	<u>fine sand</u>	<u>30</u>	<u>50'</u>
WELL COMPLETION DATA: (1) diameter (inches) <u>2"</u>	<u>water sand</u>	<u>50</u>	<u>70'</u>
(2) total depth (feet) <u>70</u>			
(3) static water level (feet) <u>30'</u> below top of ground.			
(4) casing <u>Galv. P.</u> <u>64'</u> (material) (depth) <u>2"</u> if telescope see back. (size)			
(5) screen <u>4'</u> <u>66'</u> (length) (depth to top) <u>2"</u> <u>S.S. Strainer</u> (size) (material)			
(6) pump <u>1/2</u> <u>15</u> (HP) (yield gpm) (type power)			
(7) electric log (yes or no)			
(organization running log)			
(8) how well bottom plugged			
DRILLERS REMARKS:			


CODED

AUG 20 1970

MISS. BD. OF
WATER COMM.

If well telescopes please sketch and show depths.

GROUND LEVEL

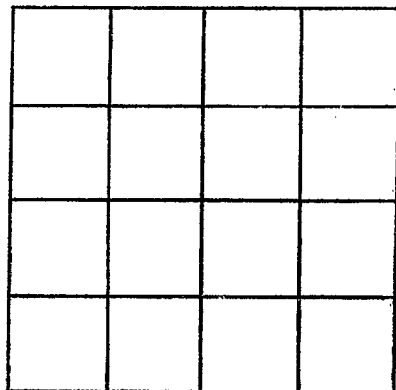

SECTION _____

Please indicate well location X.

ADDITIONAL INFORMATION

If more than one screen,
show locations of each on sketch.