

MARION
 N43
 8-70

MISSISSIPPI
 BOARD OF WATER COMMISSIONERS
 416 North State Street
 Jackson, Mississippi 39201

CODED

WATER WELL DRILLERS LOG

August 1970 E.B. SHEPPARD MARION
 date well completed firm name county well located

LANDOWNER:
 JAMES MORGAN
 FOXWORTH, Miss.
 (mailing address)

description of formations encountered from to
 SAND + GRAVEL 0 60

WELL LOCATION:
 sec. 22 T. 2 N R. 12 E
 6 miles S of Foxworth
 (distance) (direction) (nearest town)

WELL PURPOSE: DOMESTIC
 (home, irrigation, municipal, industrial)

- WELL COMPLETION DATA:
- (1) diameter (inches) 4"
 - (2) total depth (feet) 60
 - (3) static water level (feet) _____ below above top of ground.
 - (4) casing PL. 50.
 (material) (depth)
 4" if telescope see back.
 (size)
 - (5) screen 10'
 (length) (depth to top)
 4" PLASTIC
 (size) (material)
 - (6) pump 1 1/4 HP 2.5
 (HP) (yield gpm)
 E
 (type power)
 - (7) electric log (yes or no)
 - (organization running log)
 - (8) how well bottom plugged BWV

DRILLERS REMARKS:


CODED

OCT 19 1970

MISS. BD. OF
 WATER COMMISSIONERS

If well telescopes please sketch and show depths.

GROUND LEVEL

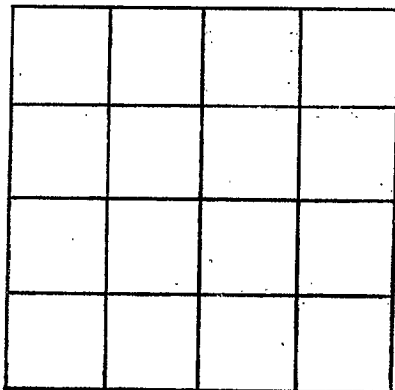

SECTION _____

Please indicate well location X.

ADDITIONAL INFORMATION

Lined area for providing additional information.

If more than one screen, show locations of each on sketch.