

MISSISSIPPI
BOARD OF WATER COMMISSIONERS
416 North State Street
Jackson, Mississippi 39201

CODED

WATER WELL DRILLERS LOG

MARION
N 46
12-22-67

12-22 date well completed
167 Fitzgerald Water Well firm name
MARION county well located

LANDOWNER: Wilbert Sorrell
Sandy Hook - Rt MISS
(mailing address)

description of formations encountered	from	to
<u>Topsoil/clay</u>	<u>0</u>	<u>25</u>
<u>Red Sand</u>	<u>25</u>	<u>150</u>
<u>Chalk</u>	<u>150</u>	<u>195</u>
<u>Sand & gravel</u>	<u>195</u>	<u>265</u>
<u>Chalk</u>	<u>265</u>	<u>265</u>

WELL LOCATION:
sec. 1 T. 1 N. R. 13 E
5 miles NW of Sandy Hook
(distance) (direction) (nearest town)

WELL PURPOSE:
(home, irrigation, municipal, industrial)

WELL COMPLETION DATA:

(1) diameter (inches) 4

(2) total depth (feet) 260

(3) static water level (feet) 140 below top of ground.

(4) casing plastic 252
(material) (depth)
4 if telescope see back.
(size)


(5) screen 8 252
(length) (depth to top)
2 plastic
(size) (material)

(6) pump 1/2 12
(HP) (yield gpm)
elec
(type power)

(7) electric log NO
(yes or no)
(organization running log)

(8) how well bottom plugged


CODED

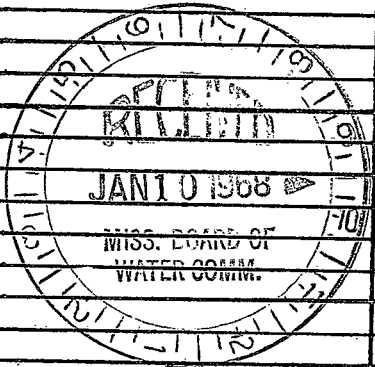

DRILLERS REMARKS:

If well telescopes please sketch and show depths.

GROUND LEVEL

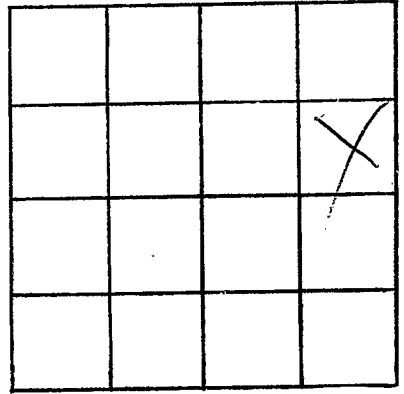

SECTION /

Please indicate well location X.

ADDITIONAL INFORMATION

If more than one screen, show locations of each on sketch.