

MARION

N47

2-2-68

MISSISSIPPI BOARD OF WATER COMMISSIONERS  
416 North State Street  
Jackson, Mississippi 39201

**CODED**

WATER WELL DRILLERS LOG

Feb 2

1968

Fitzgerald well dr

firm name

Marion

county well located

LANDOWNER: A. J. Ryan

R.R.

Tylertown, Miss  
(mailing address)

WELL LOCATION:

sec. 14 T-2 R-12 E

3 miles SE of Knoka  
(distance) (direction) (nearest town)

WELL PURPOSE: Home  
(home, irrigation, municipal, industrial)

WELL COMPLETION DATA:

- (1) diameter (inches) 4"
- (2) total depth (feet) 131'
- (3) static water level (feet) 115' below top of ground.

- (4) casing Plastic, 125' (material) (depth)  
4" (size) if telescope see back.

- (5) screen 6' (length), 125' (depth to top)

- 4" (size) Plastic (material)

- (6) pump 3 (HP) 3 (yield gpm)

- Electric (type power)

- (7) electric log No (yes or no)


(organization running log)

- (8) how well bottom plugged Red fly

DRILLERS REMARKS:

| description of formations encountered | from | to  |
|---------------------------------------|------|-----|
| Red clay                              | 0    | 20  |
| Red sand                              | 20   | 80  |
| Red clay & soap                       | 80   | 120 |
| Coarse sand & gravel                  | 120  | 131 |

**CODED**

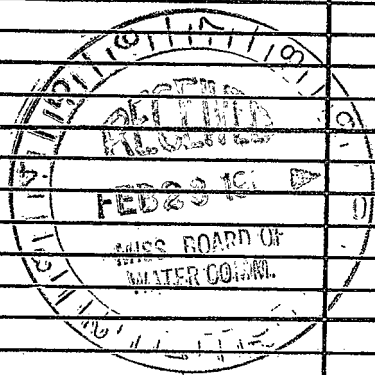

If well telescopes please sketch and show depths.

GROUND LEVEL

|   |  |  |  |
|---|--|--|--|
|   |  |  |  |
|   |  |  |  |
|   |  |  |  |
| X |  |  |  |

SECTION 14

Please indicate well location X.

ADDITIONAL INFORMATION

If more than one screen, show locations of each on sketch.