

MISSISSIPPI  
BOARD OF WATER COMMISSIONERS  
416 North State Street  
Jackson, Mississippi 39201

**CODED**

WATER WELL DRILLERS LOG

MARION  
N 50  
1-71

JAN. 1971  
date well completed

E. B. SHERRARD  
firm name

MARION  
county well located

LANDOWNER:	description of formations encountered	from	to
JOHNNY STRINGER Pt. 2 - FOXWORTH, Miss. (mailing address)			
WELL LOCATION: sec. 8 T. 2 N. R. 2 E. 1/2 miles SW FOXWORTH (distance) (direction) (nearest town)			
WELL PURPOSE: (Home) Irrigation, municipal, industrial			
WELL COMPLETION DATA:			
(1) diameter (inches) 2"			
(2) total depth (feet) 82'			
(3) static water level (feet) 40' below top of ground.			
(4) casing PL, 75' (material) (depth) 2" If telescope see back. (size)			
(5) screen 5' (length) (depth to top) 2" PL (size) (material)			
(6) pump 3/4 HP, 9 (yield gpm) E (type power)			
(7) electric log (yes or no)			
(organization running log)			
(8) how well bottom plugged B W V			
DRILLERS REMARKS:			


**CODED**

FEB 1 1971

MISS. BD. OF  
WATER COM.

If well telescopes please sketch and show depths.

GROUND LEVEL

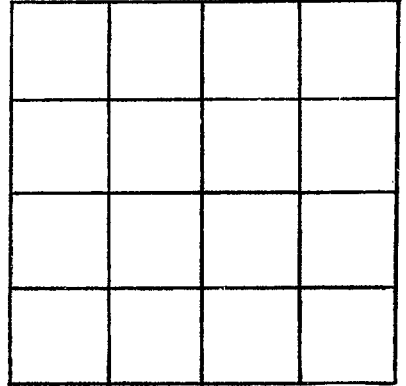

SECTION \_\_\_\_\_

Please indicate well location X.

ADDITIONAL INFORMATION

If more than one screen,  
show locations of each on sketch.