

MARION
 N 51
 2-19-71

MISSISSIPPI
 BOARD OF WATER COMMISSIONERS
 416 North State Street
 Jackson, Mississippi 39201

CODED

WATER WELL DRILLERS LOG

2-19-71 date well completed
 Desha Trice Well Service firm name
 Marion county well located

LANDOWNER:	description of formations encountered	from	to
Charles Louis May Route 2 Igworth miss (mailing address)			
	Chalk	1	7.7
WELL LOCATION: sec. 5 T. 2 N. R. 13 E 1.5 miles South of Columbia (distance) (direction) (nearest town)	fine sand	7.7	10.5
	water sand	10.5	14.7
WELL PURPOSE: Home Use (home, irrigation, municipal, industrial)			
WELL COMPLETION DATA:			
(1) diameter (inches) 2"			
(2) total depth (feet) 147'			
(3) static water level (feet) 64' below top of ground.			
(4) casing (material) Plastic, (depth) 135'			
(size) If telescope see back.			
(5) screen (length) 10', (depth to top) 137'			
(size) 2", (material) Plastic			
(6) pump (HP) 1 (yield gpm)			
(type power)			
(7) electric log (yes or no)			
(organization running log)			
(8) how well bottom plugged			
DRILLERS REMARKS:			


CODED

MAR 18 1971

MISS. BU. OF
 WATER CONTROL

If well telescopes please sketch and show depths.

GROUND LEVEL

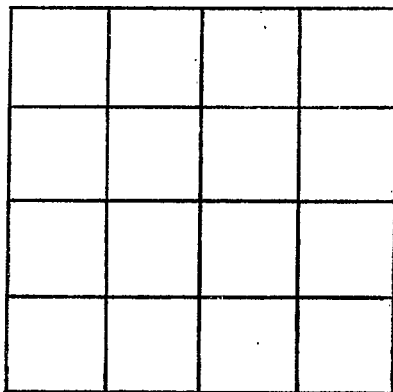

SECTION _____

Please indicate well location X.

ADDITIONAL INFORMATION

If more than one screen, show locations of each on sketch.