

MARION
 N52
 4-22-71

MISSISSIPPI
 BOARD OF WATER COMMISSIONERS
 416 North State Street
 Jackson, Mississippi 39201

CODED

WATER WELL DRILLERS LOG

4-22-71 date well completed
 Dean Stone Well Service firm name
 Marion county well located

LANDOWNER:
 Ronald Ramura
 Route 2 Foxworth Miss
 (mailing address)

description of formations encountered	from	to
top soil	0	1
Red Clay	1	15

WELL LOCATION:
 sec. 4 T. 20 N. R. 13 E
 18 miles S of Columbus
 (distance) (direction) (nearest town)

sand & gravel	15	70
Water sand	70	146

WELL PURPOSE: Home Use
 (home, irrigation, municipal, industrial)

WELL COMPLETION DATA:

(1) diameter (inches) 2"

(2) total depth (feet) 146'

(3) static water level (feet) 75' below top of ground.

(4) casing Plastic, 137' (material) (depth)

(size) If telescope see back.

(5) screen 7' (length) 139' (depth to top)

2" Plastic (size) (material)

(6) pump 1 (HP) (yield gpm)

(type power)

(7) electric log No (yes or no)

(organization running log)

(8) how well bottom plugged

CODED


APR 28 1971

MISS. BD. OF
 WATER COMM.

DRILLERS REMARKS:

If well telescopes please sketch and show depths.

GROUND LEVEL

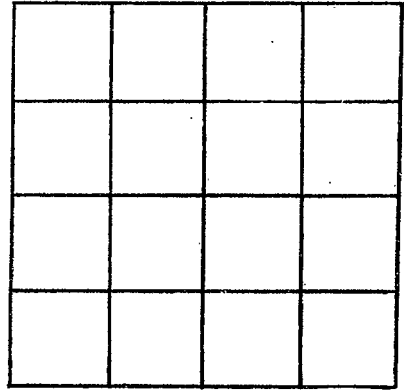

SECTION _____

Please indicate well location X.

ADDITIONAL INFORMATION

If more than one screen, show locations of each on sketch.